




CB&I Nederland B.V.



Project Name:	Hydrocracker Complex
Project Number:	183700
Supplier Name:	Flowserve b.v.
Requisition Number:	183700-MR-0110-001
CBI Document Number:	183700-0110-001-SD-000117
Document Title:	Local Panel Connection/ Wiring Diagrams P-3111 A/B
Supplier Document Number:	ETL150046-047-81260-01
Equipment / Tag No('s):	P-3111A/B
SDR Code(s):	K10-D26

CB&I		
Hydrocracker Complex (183700)		
Engineering Review Status	By:	
Code 1 - No Comments	JAKUB.SVOBOD	
	A	
	Date: 24.07.2018	
<small>These comments do not relieve the supplier of his responsibility to meet the requirements of the P.O.</small>		


Supplier's Issue Record

Supplier Document Revision Indicator	Issue Date	Description	By	Checked	Approved
07	16/Jul/2018	As built	Supplier	B. Weenink	C. Goossens
06	04/Apr/2018	Final - Implemented terminals interconnections	Srinivasan, N	Munoz, Alicia	Goossens, Christian
05	12/Feb/2018	As built	Narasimhalah, Naveen Kumar	Munoz, Alicia	Kop, John
04	08/Aug/2017	As built	Narasimhalah, Naveen Kumar	Munoz, Alicia	Munoz, Alicia
03	27/Jun/2017	As built	Munoz, Alicia	Kop, John	Kop, John
02	20/Jan/2017	For Review	Enkhuizen , Patrick van	Enkhuizen , Patrick van	Enkhuizen , Patrick van
01	25/Jul/2016	For Review	Enkhuizen , Patrick van	Enkhuizen , Patrick van	Enkhuizen , Patrick van
0	27/Dec/2016	First Issue	Enkhuizen , Patrick van	Enkhuizen , Patrick van	Kop, John

The copyright of this drawing is property of Electromach B.V. the Netherlands and may not as whole or in a part be copied, reproduced or shown to any other parties, without company's written permission.


The copyright of this drawing is property of Electromach B.V. the Netherlands and may not as whole or in a part be copied, reproduced or shown to any other parties, without company's written permission.

0	1	2	3	4	5	6	7	8	9
---	---	---	---	---	---	---	---	---	---

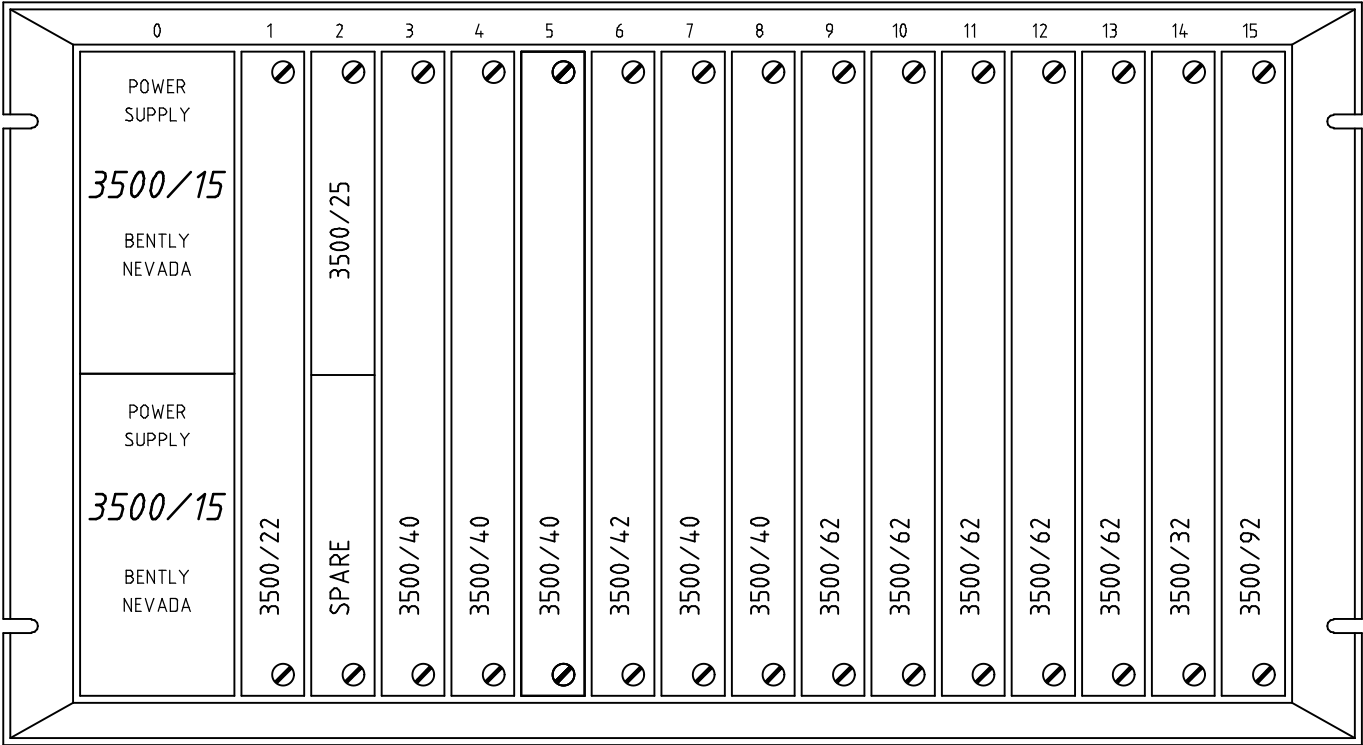


RACK 1
FOR P-3111A


0	1	2	3	4	5	6	7	8	9
---	---	---	---	---	---	---	---	---	---

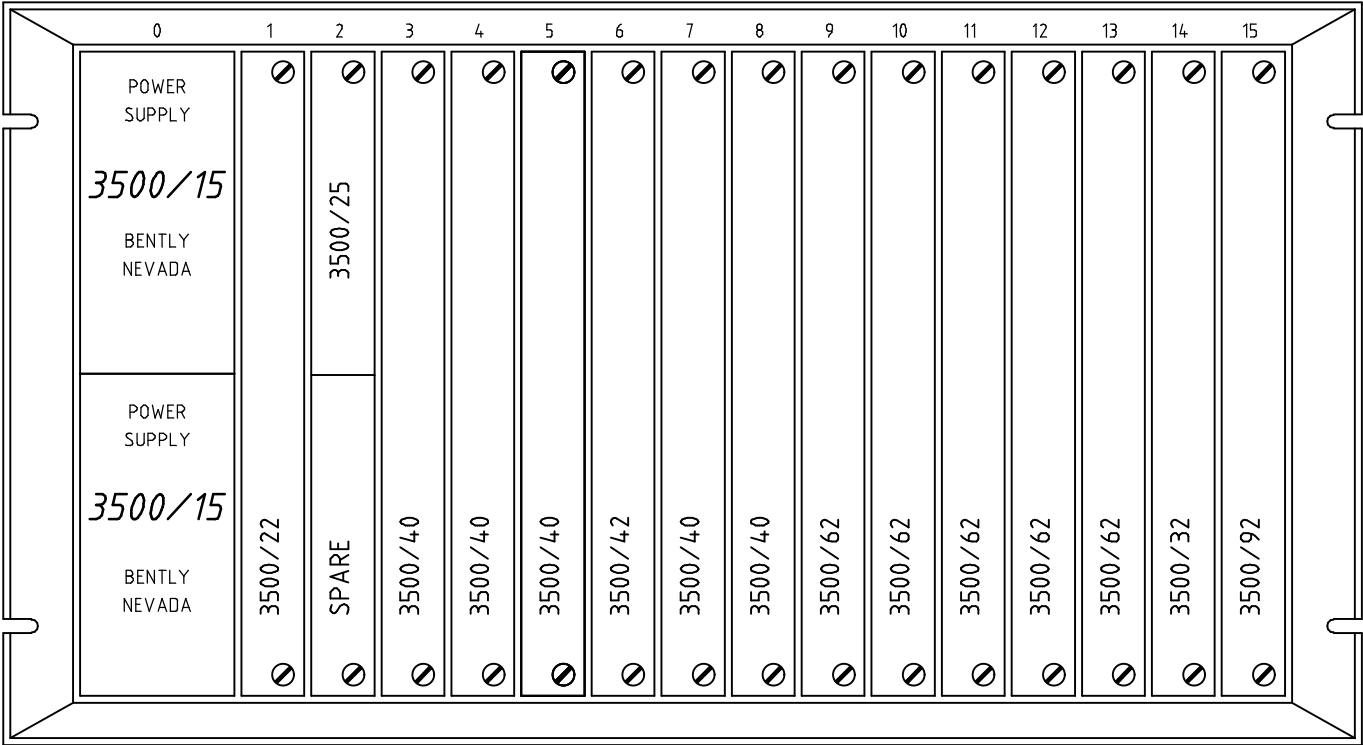


RACK 2
 FOR P-3111B

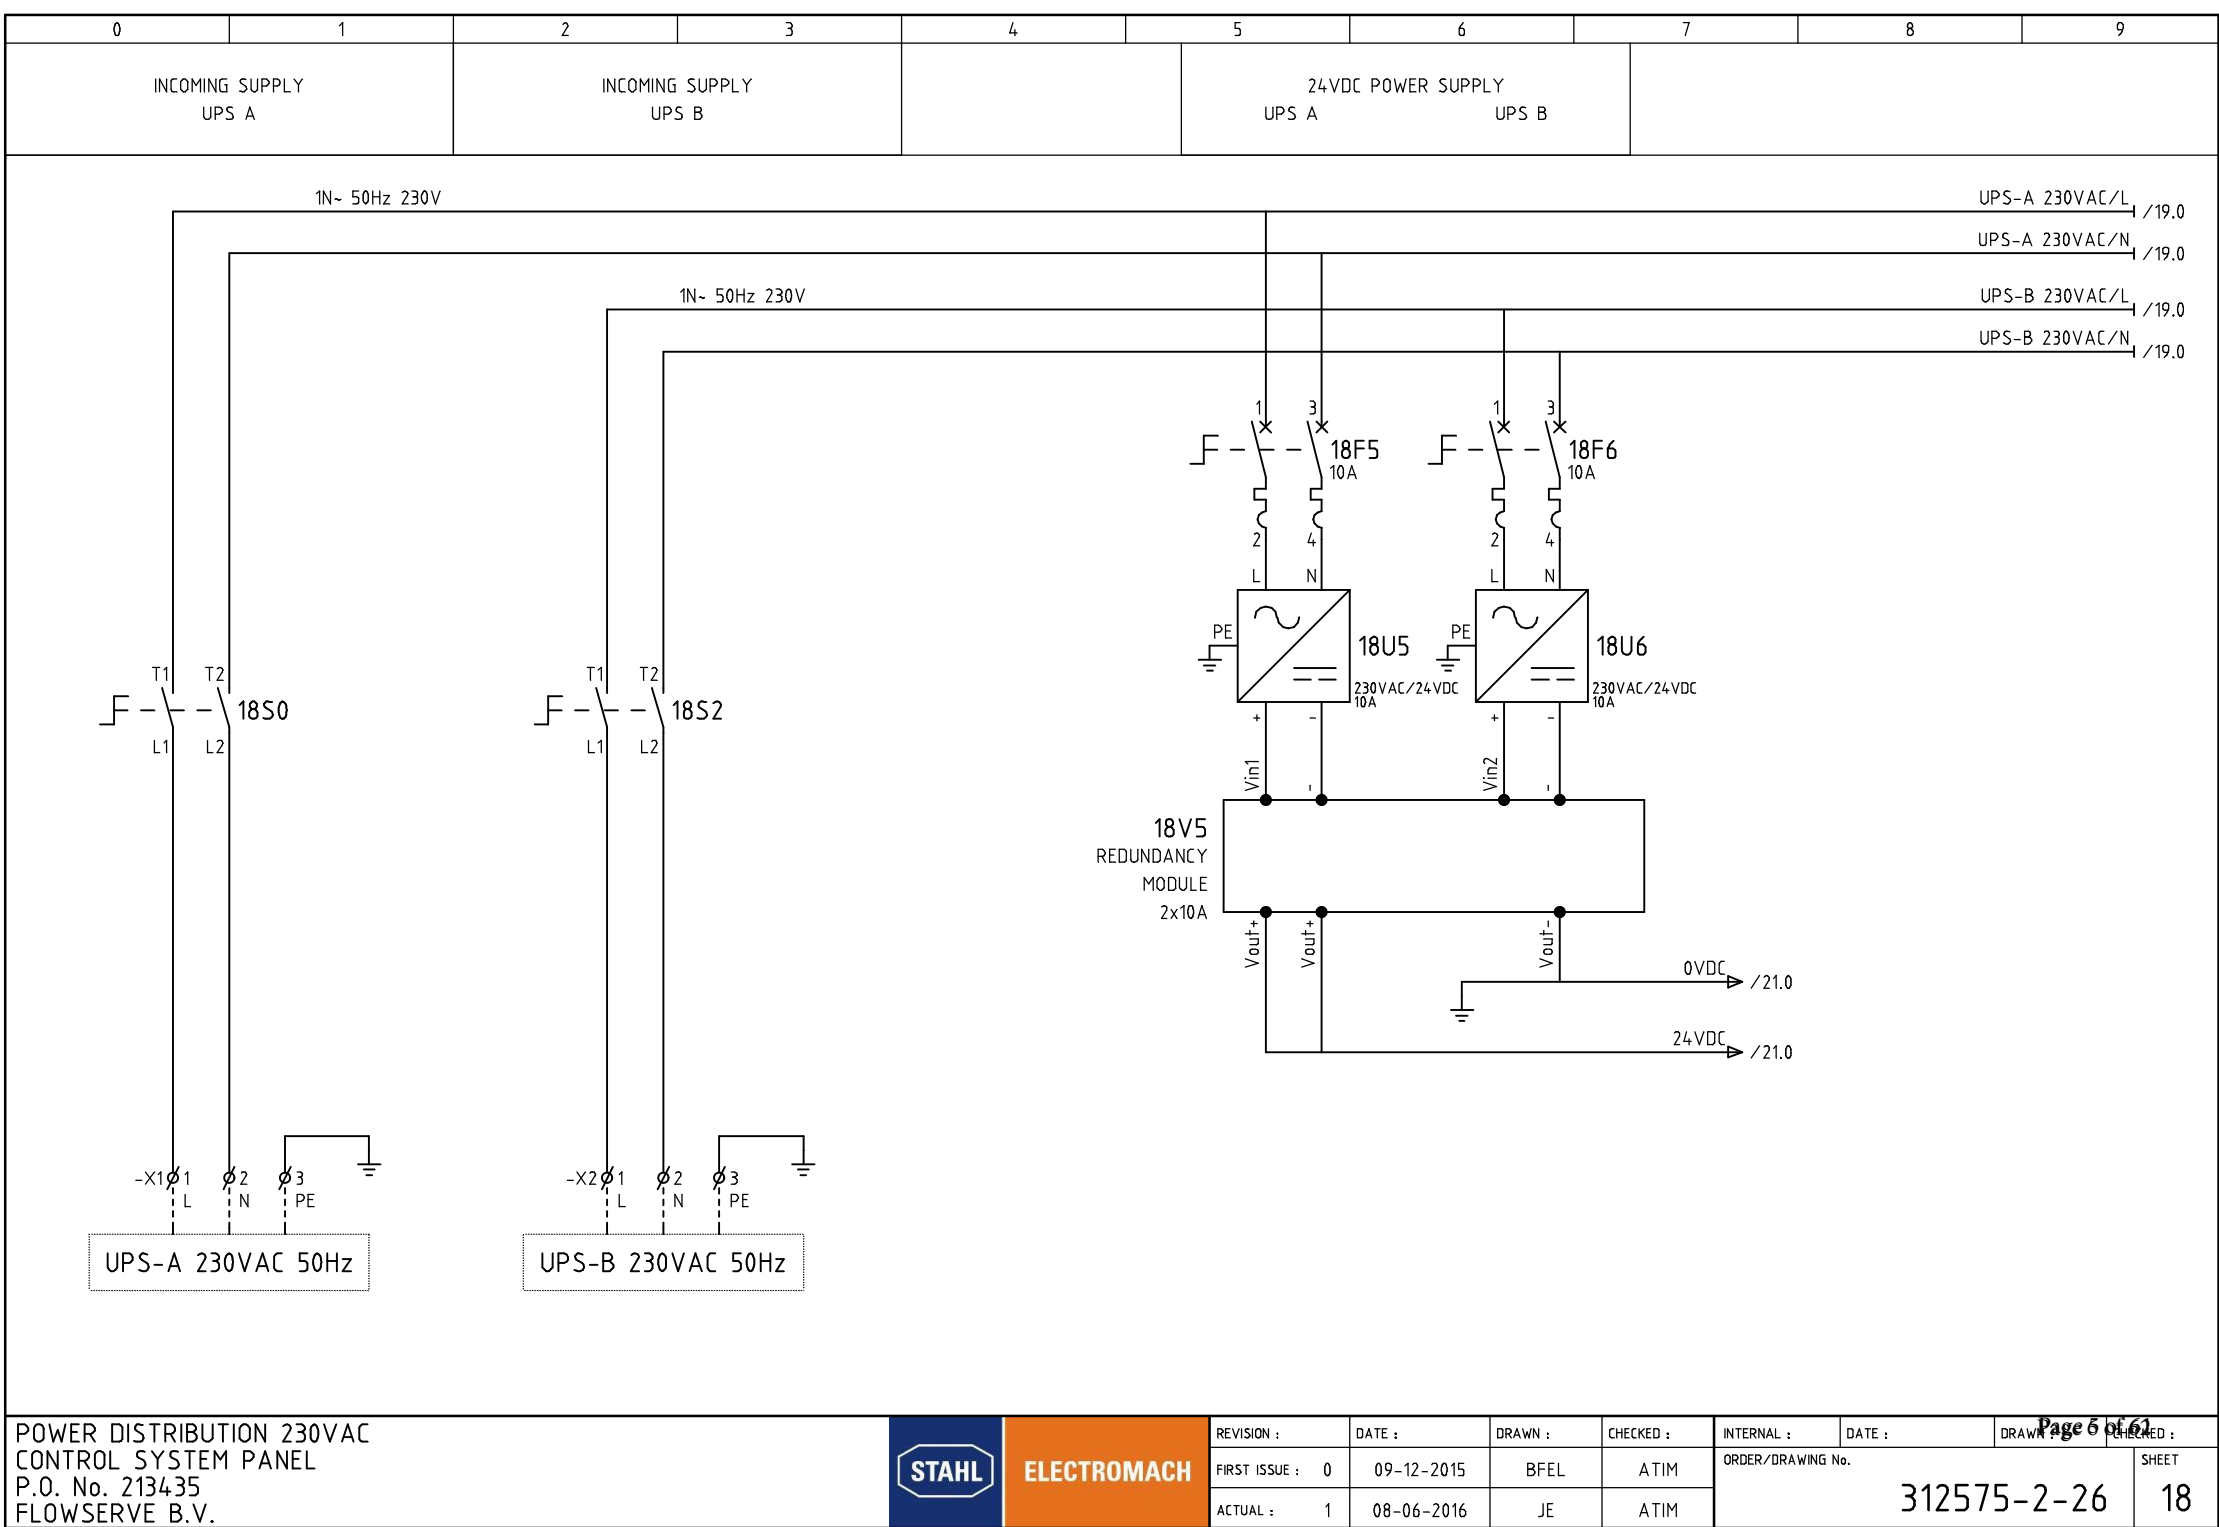


0	1	2	3	4	5	6	7	8	9
	POWER SUPPLY BENTLY NEVADA RACK 1 UPPER			POWER SUPPLY BENTLY NEVADA RACK 1 LOWER		POWER SUPPLY BENTLY NEVADA RACK 2 UPPER		POWER SUPPLY BENTLY NEVADA RACK 2 LOWER	

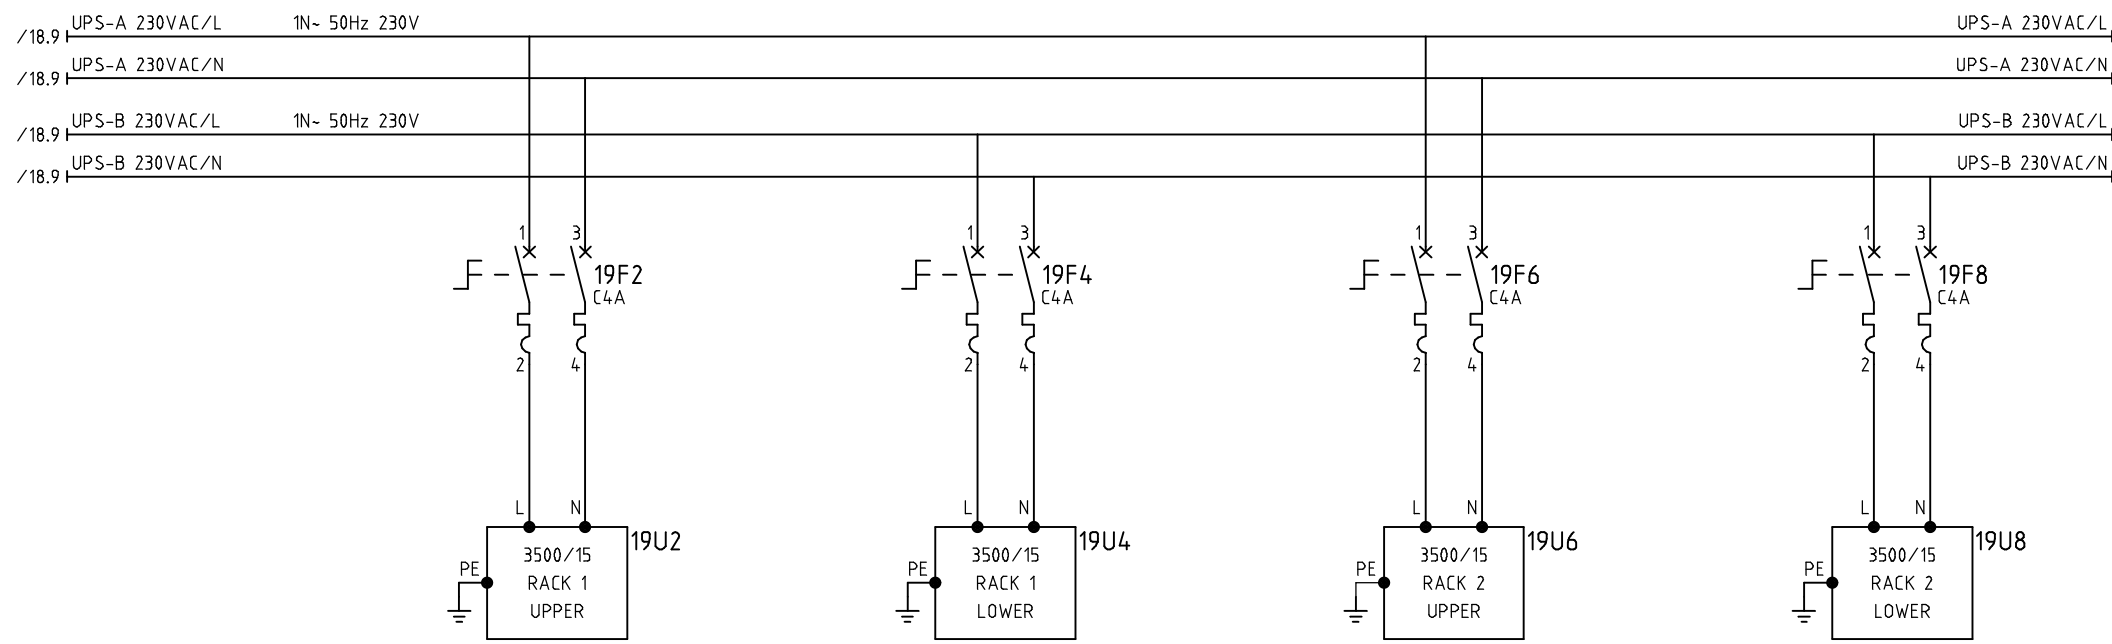

0	1	2	3	4	5	6	7	8	9
	INCOMING SUPPLY UTILITY FEEDER		PANEL LIGHTING + UTILITY SOCKET				SPARE		

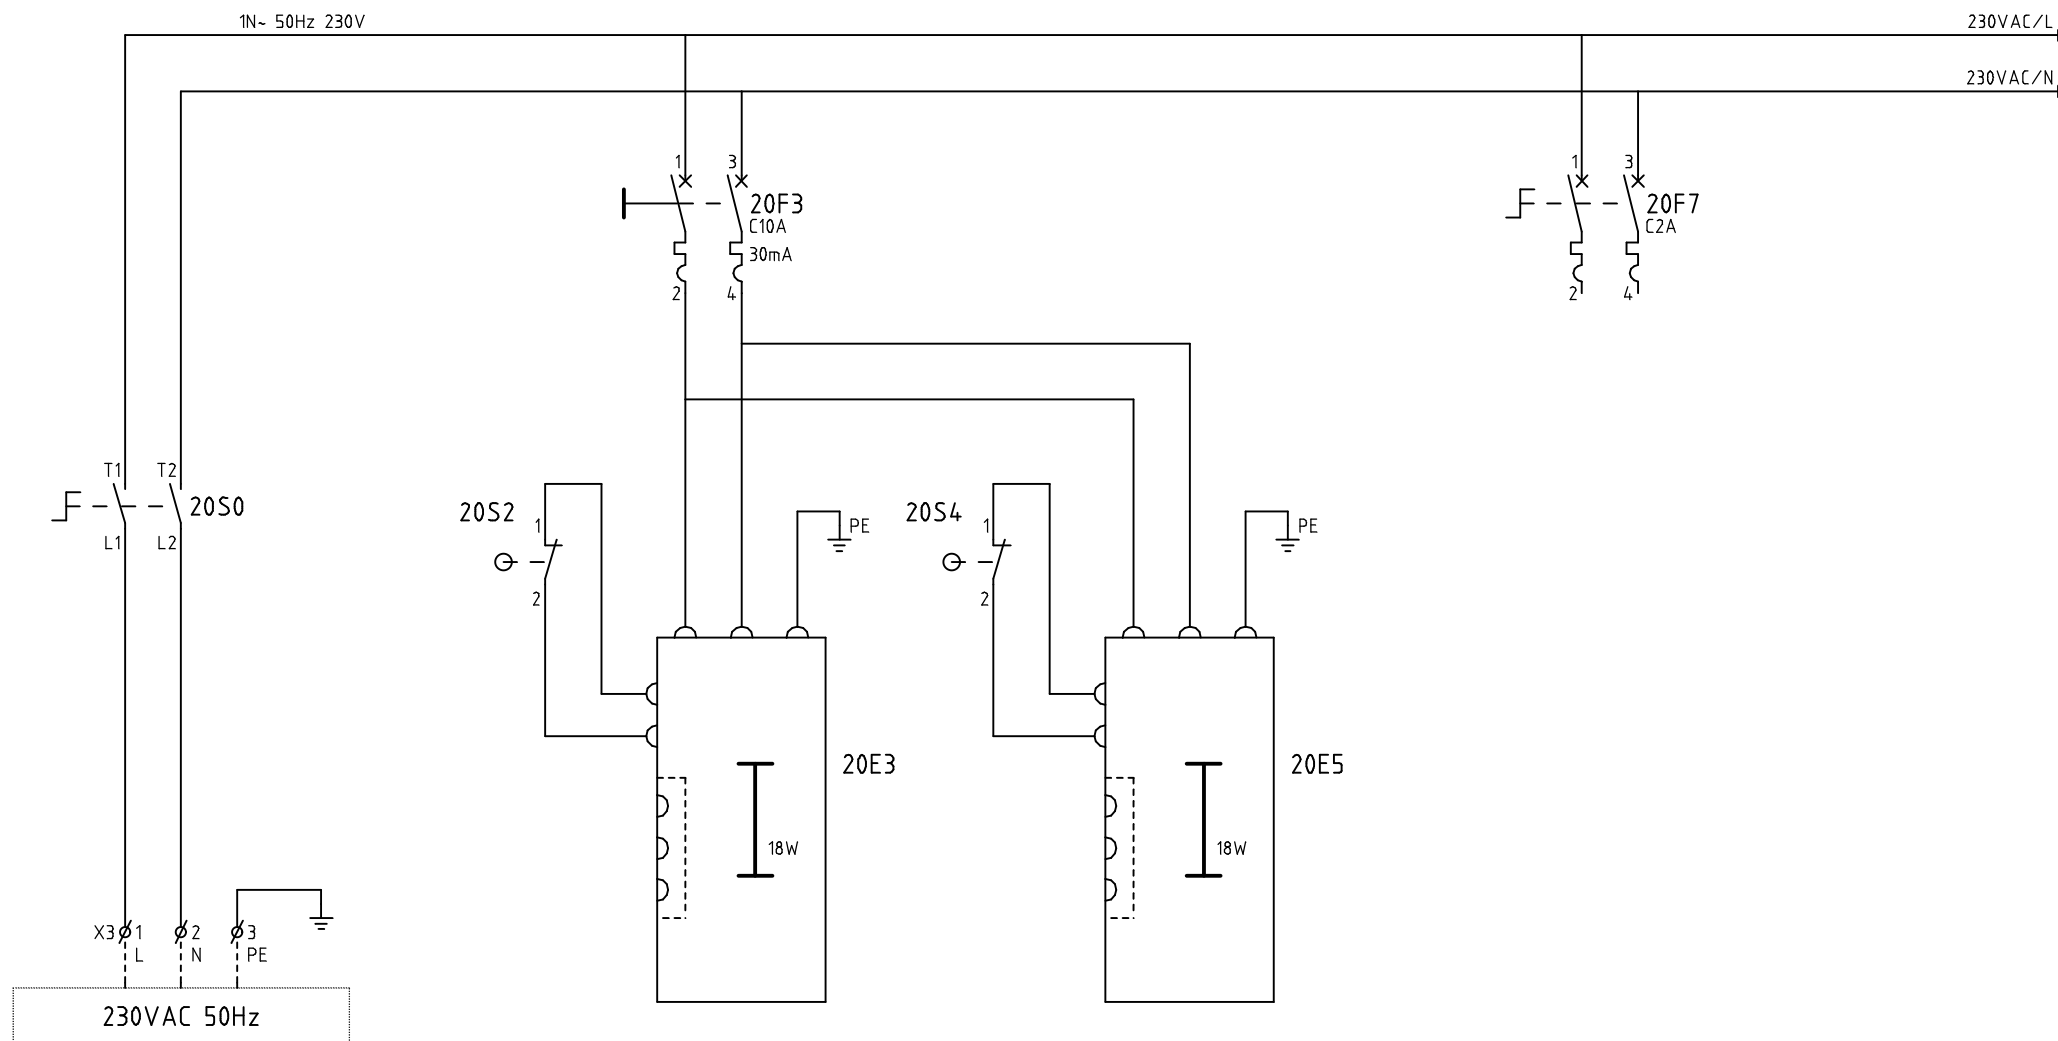


0	1	2	3	4	5	6	7	8	9
	24VDC SUPPLY ISOLATORS RACK 1	24VDC SUPPLY ISOLATORS RACK 2	24VDC SUPPLY ETHERNET SWITCH	PANEL VENTILATION					

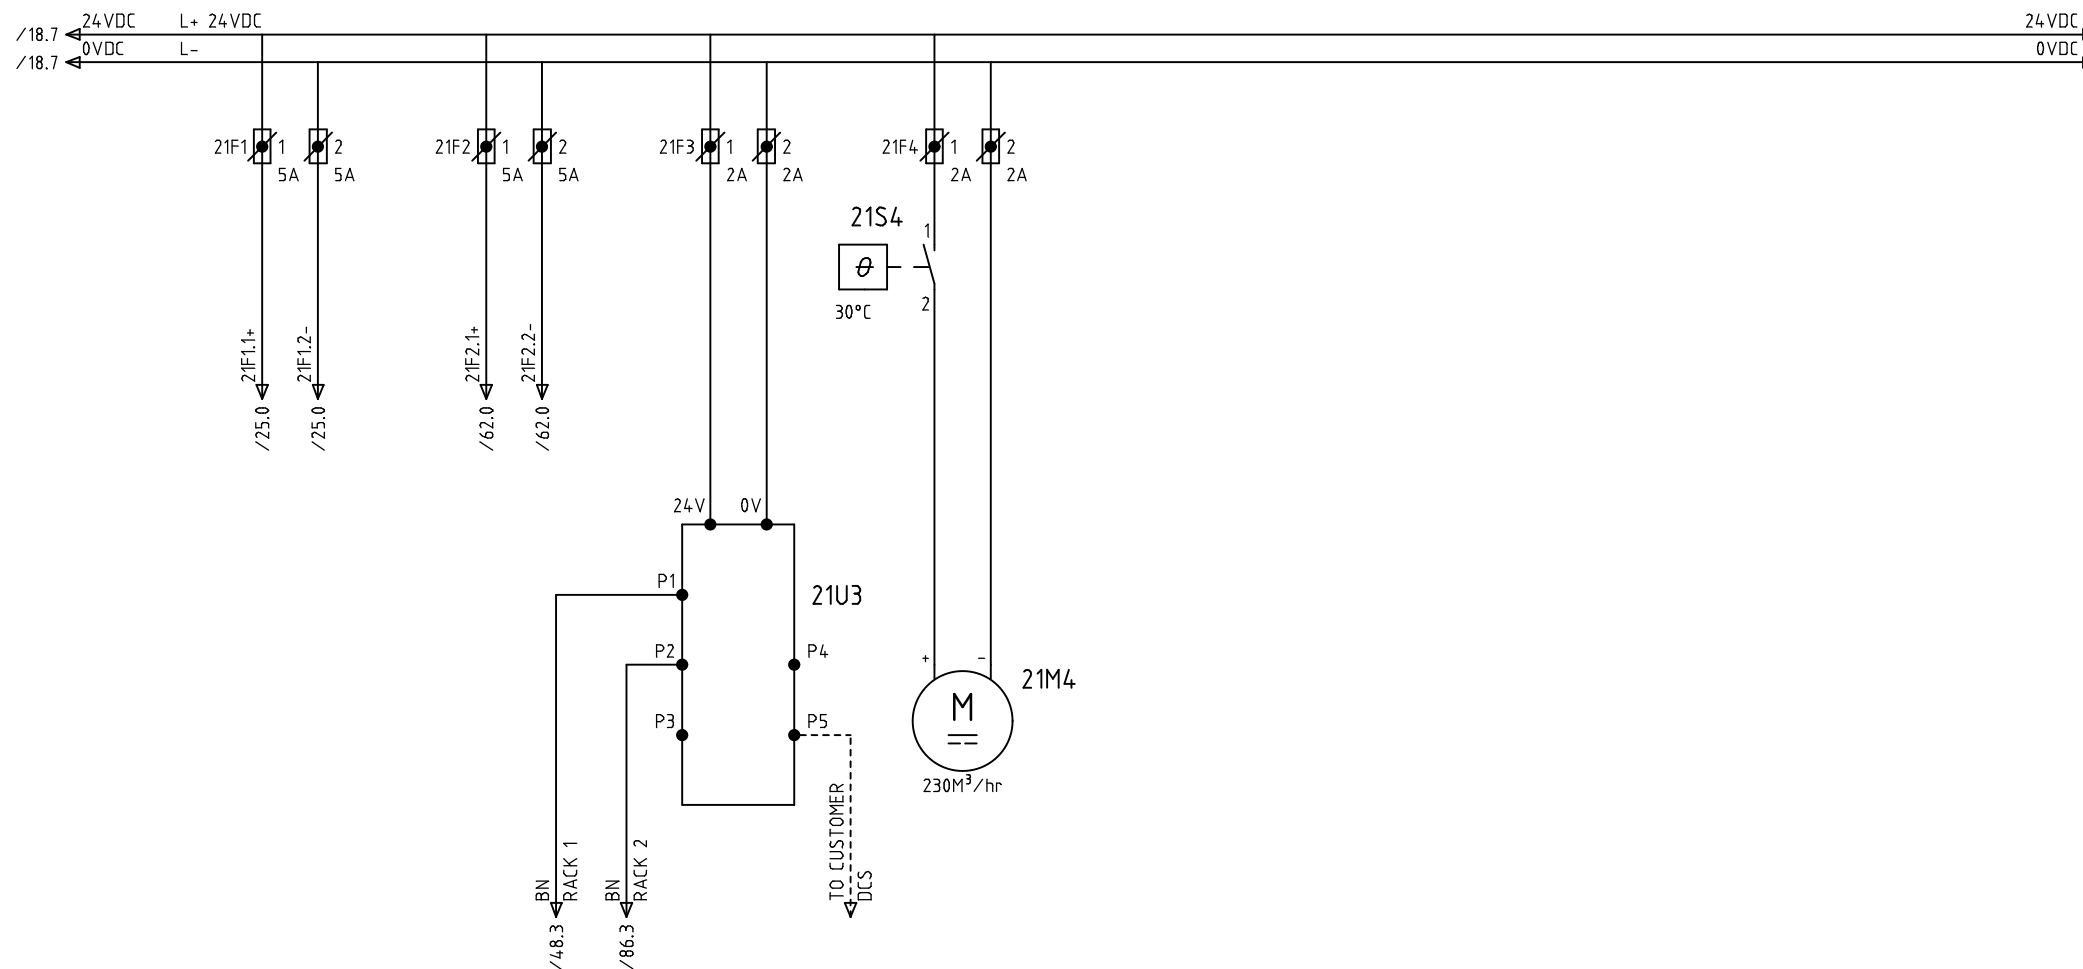

RACK INTERFACE MODULE 3500/22M-01-01-00

23U1
BN RACK 1
SLOT 1

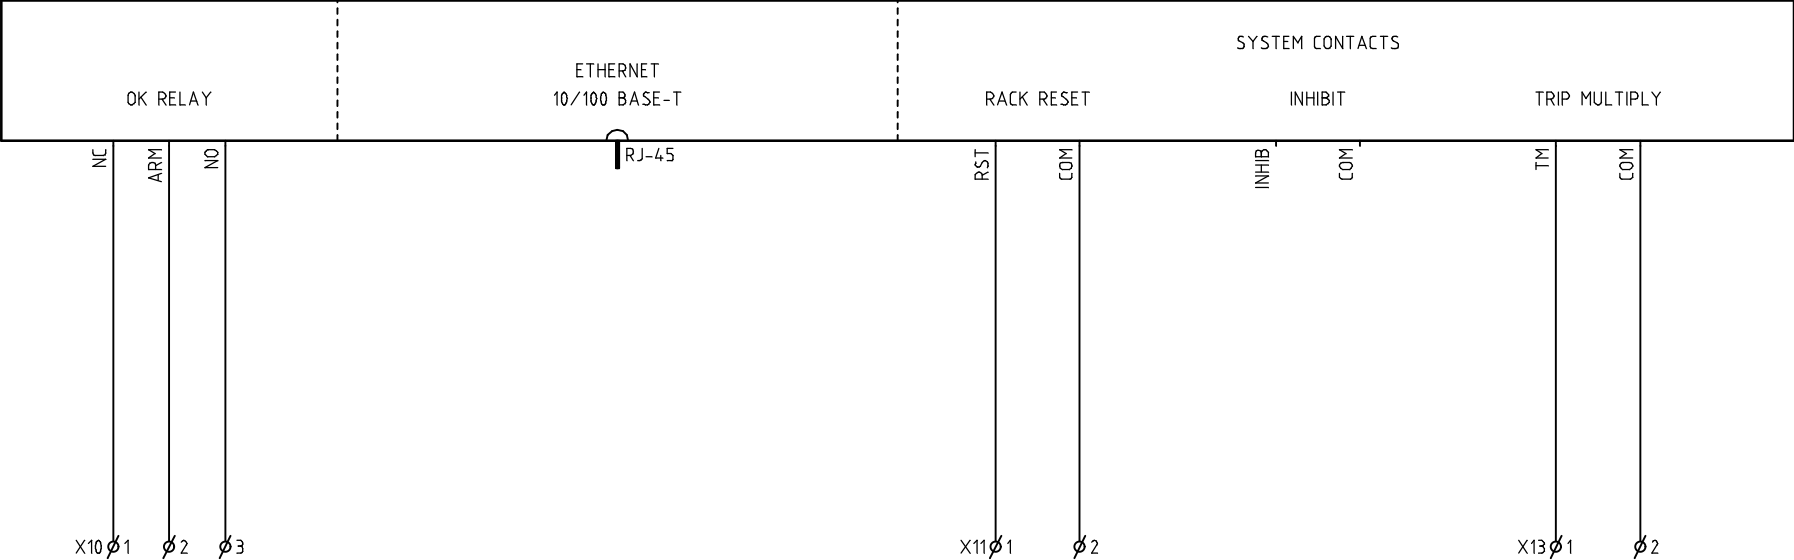


EXTERNAL

3104XS-0340

3104XY-0341

3104XY-0342

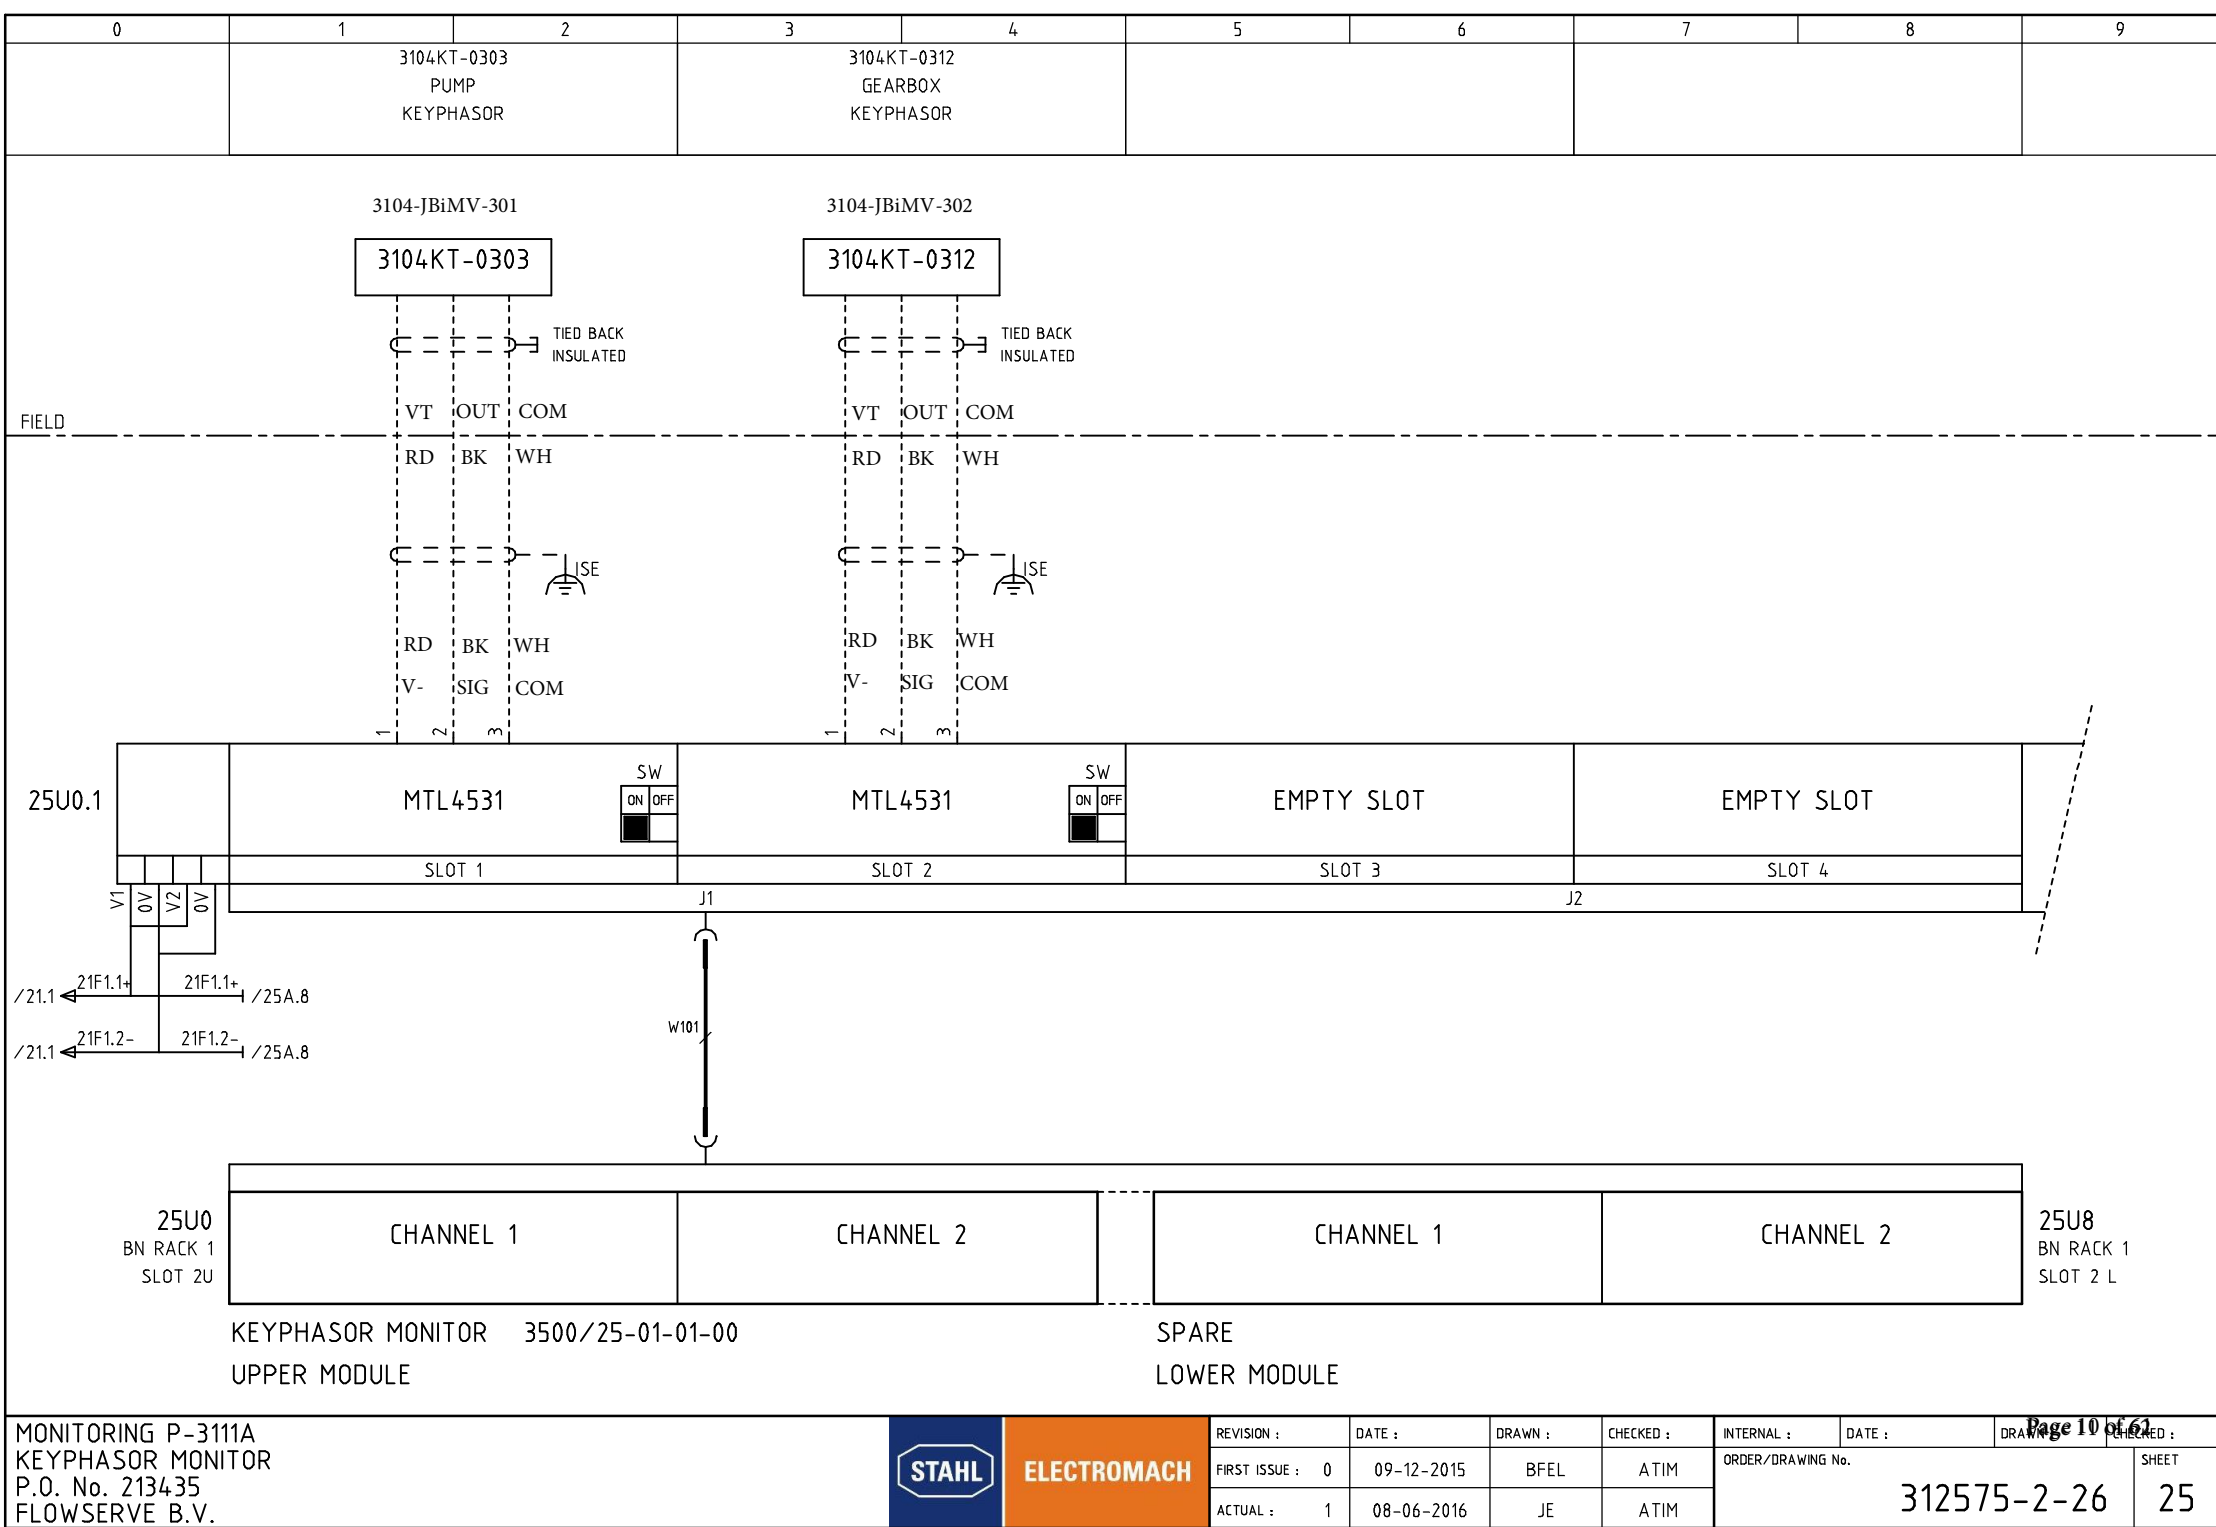

MONITORING P-3111A

KEYPHASOR MONITOR

P.O. No. 213435

FLOWERVE B.V.


STAHL


ELECTROMACH

REVISION :	DATE :	DRAWN :	CHECKED :	INTERNAL :	DATE :	DRAWN :	CHECKED :
FIRST ISSUE : 0	09-12-2015	BFEL	ATIM	ORDER/DRAWING No.	312575-2-26		
ACTUAL : 1	08-06-2016	JE	ATIM	25			

Page 10 of 61

0	1	2	3	4	5	6	7	8	9

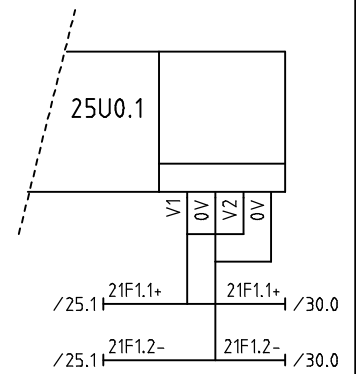

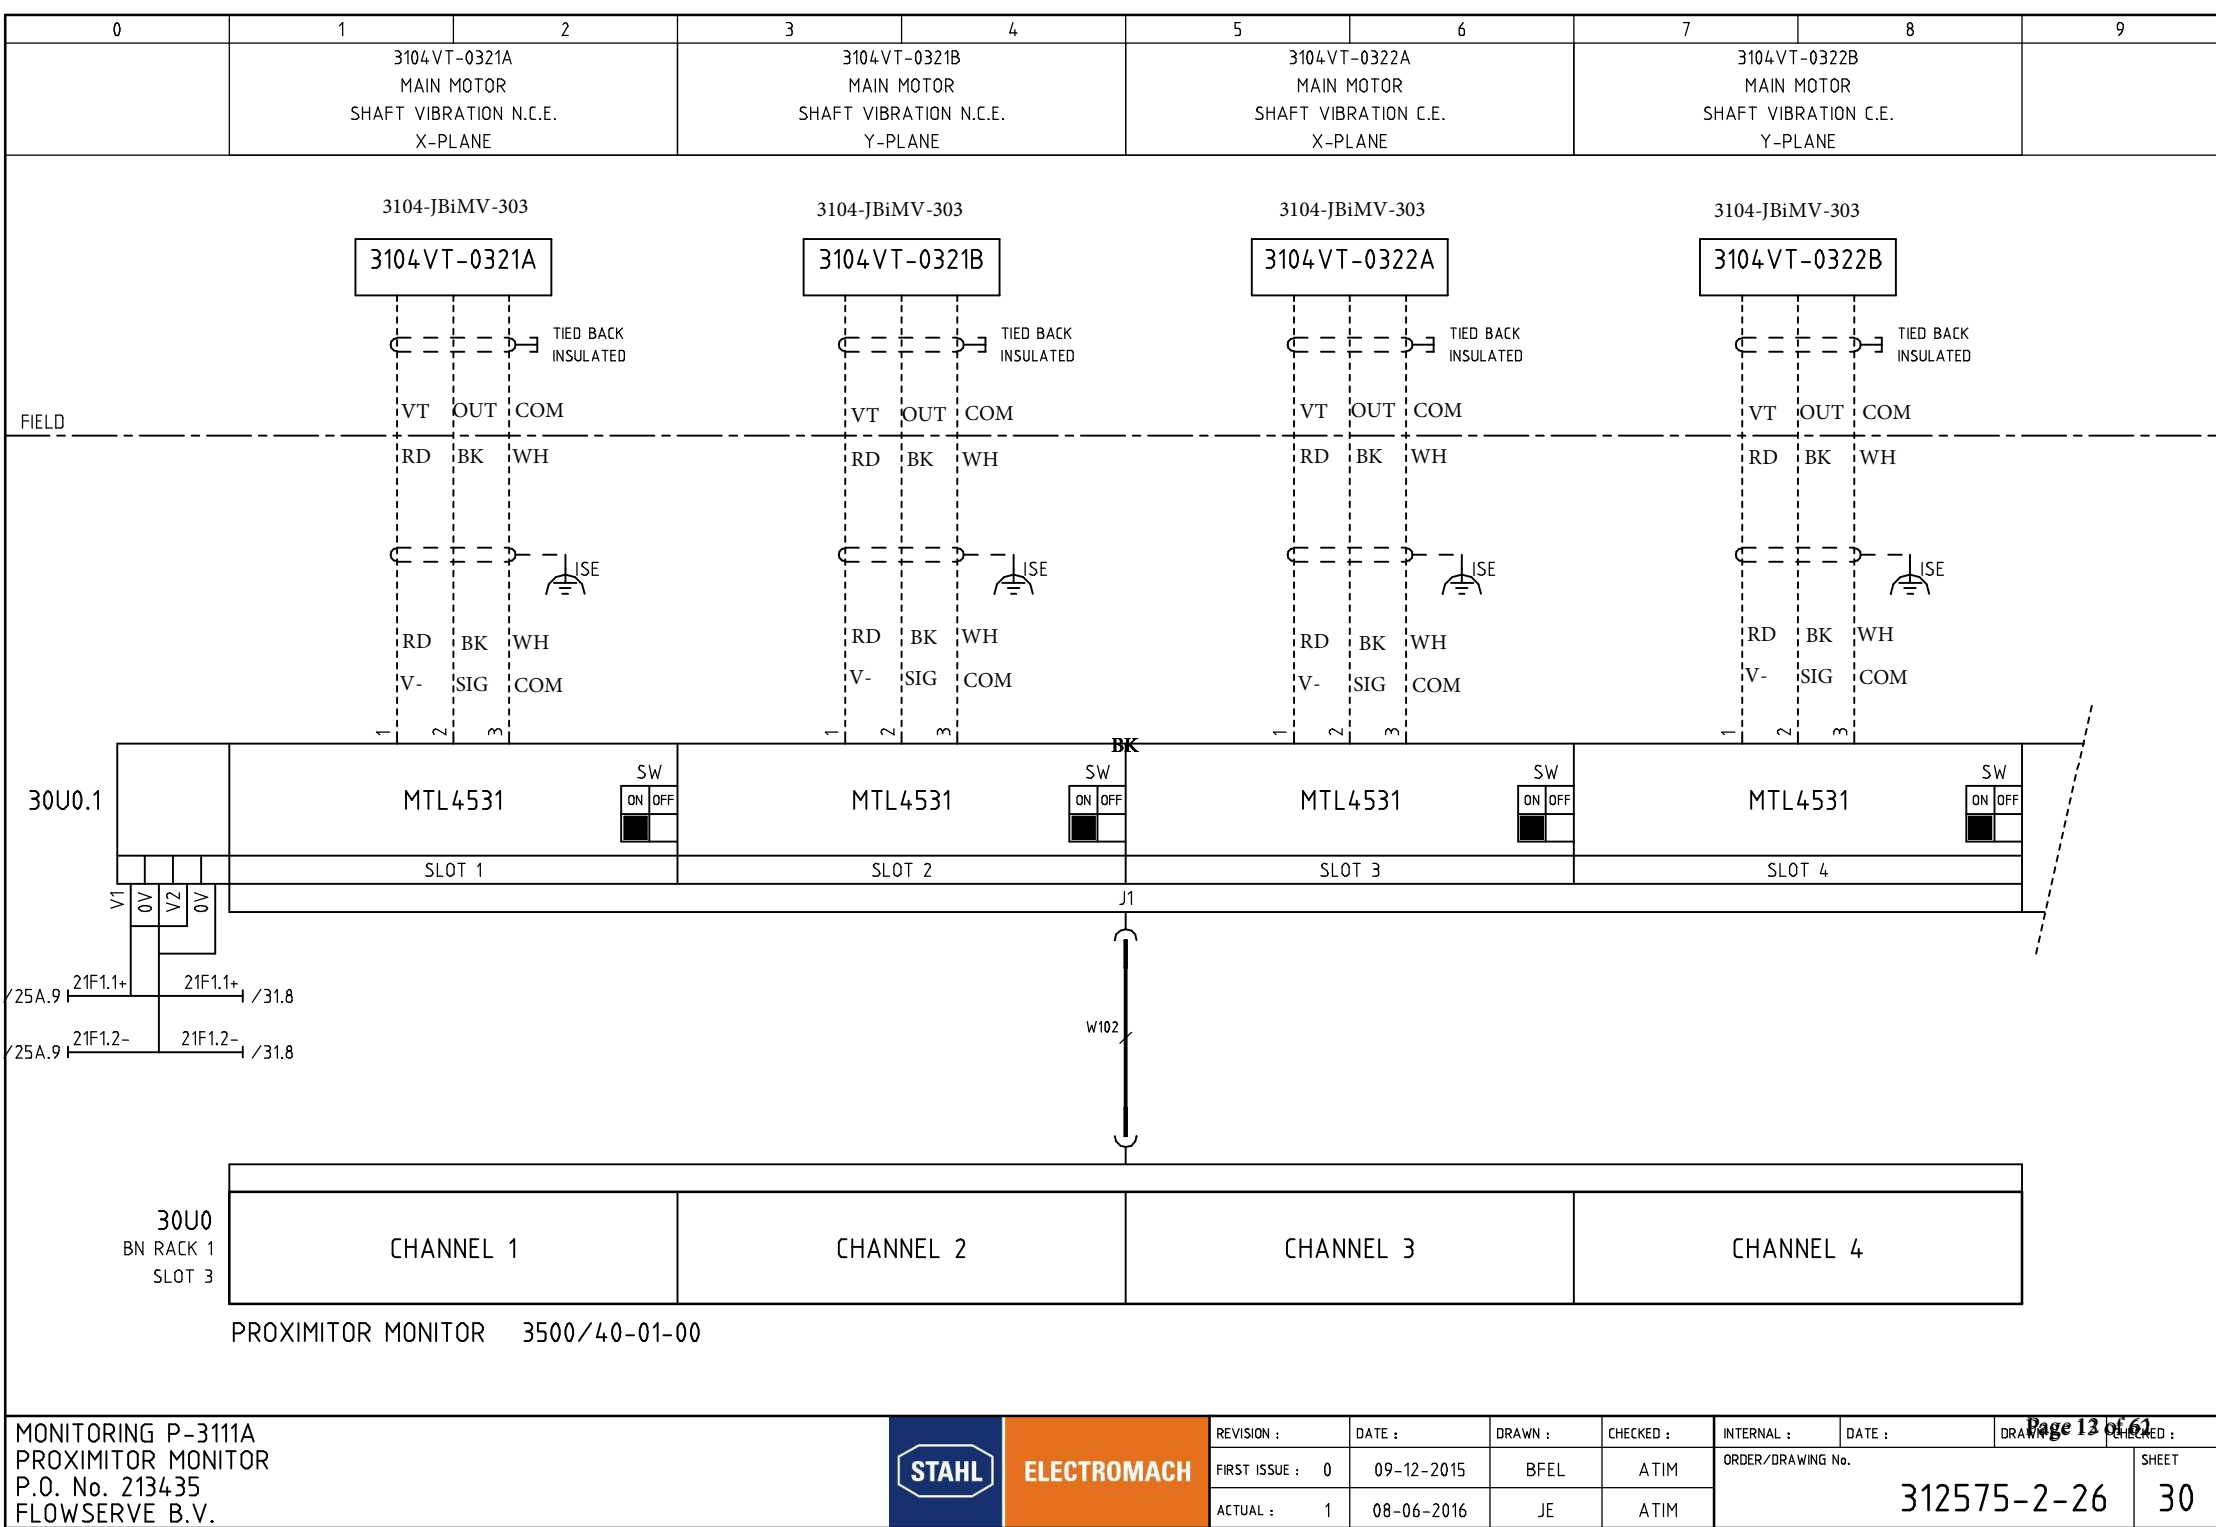

MTL4531

SW

ON

OFF

SLOT 3

MTL4531

SW

ON

OFF

SLOT 4

30U0

BN RACK 1

SLOT 3

CHANNEL 1

CHANNEL 2

CHANNEL 3

CHANNEL 4

PROXIMITOR MONITOR

3500/40-01-00

30U0.1

V1

OV

V2

OV

21F1.1+

21F1.1+

25A.9


31.8


21F1.2-

21F1.2-

25A.9

31.8

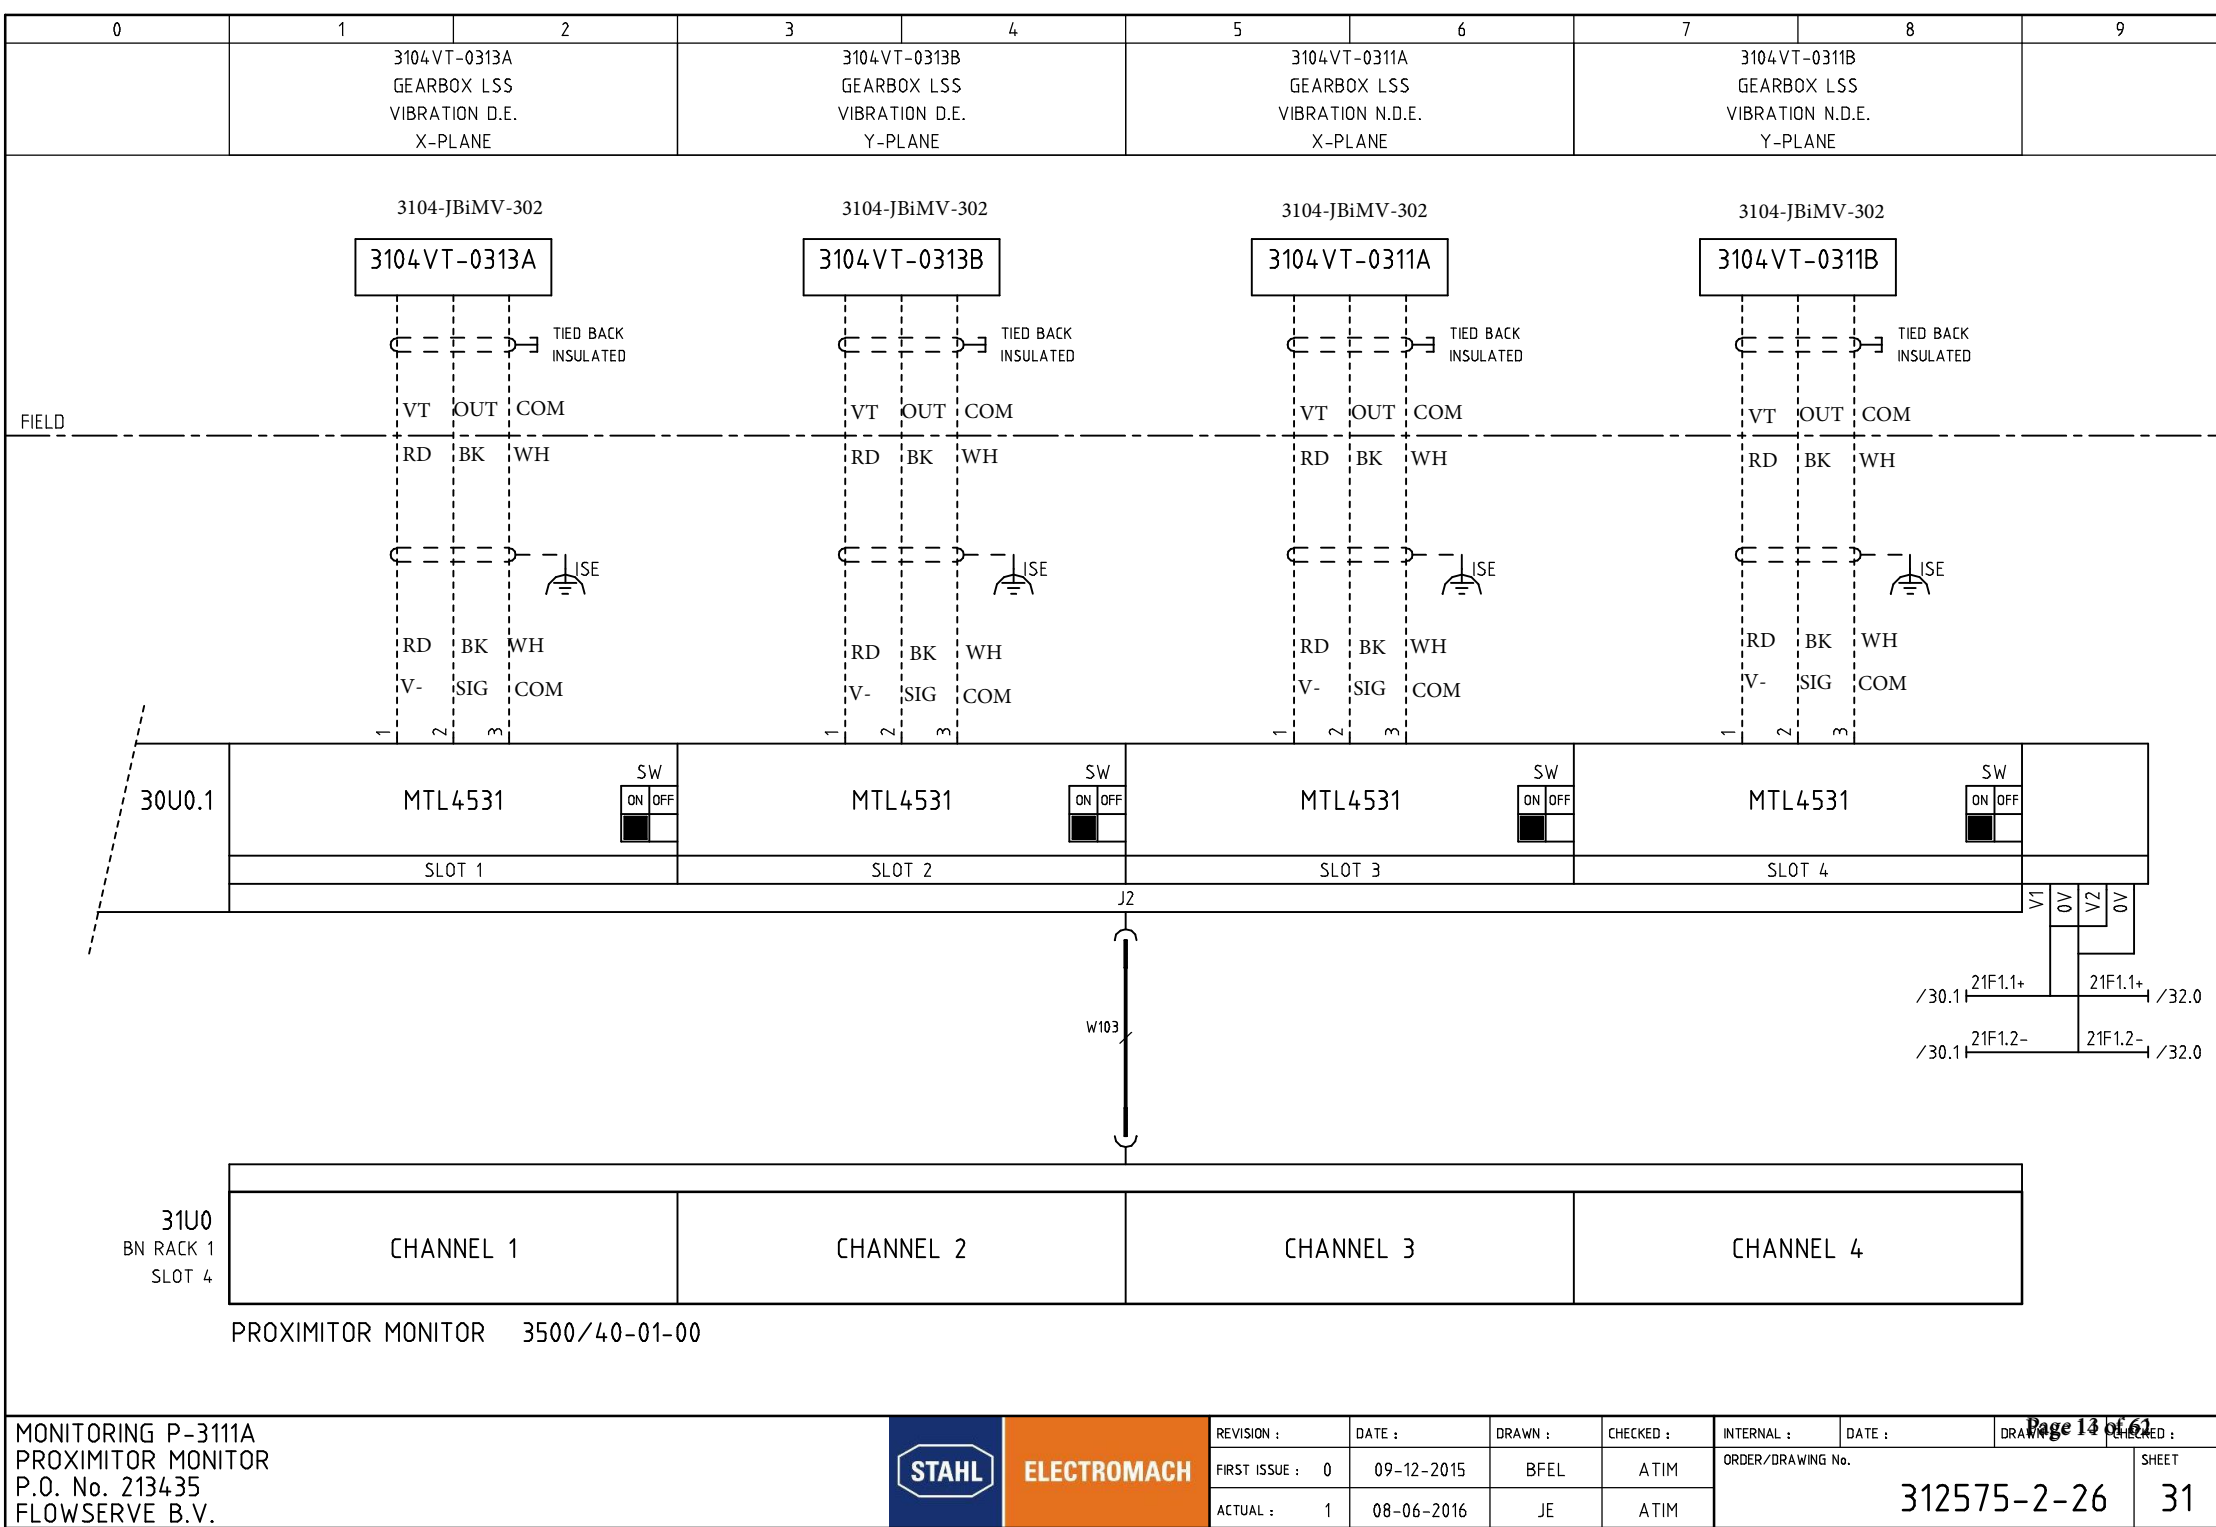

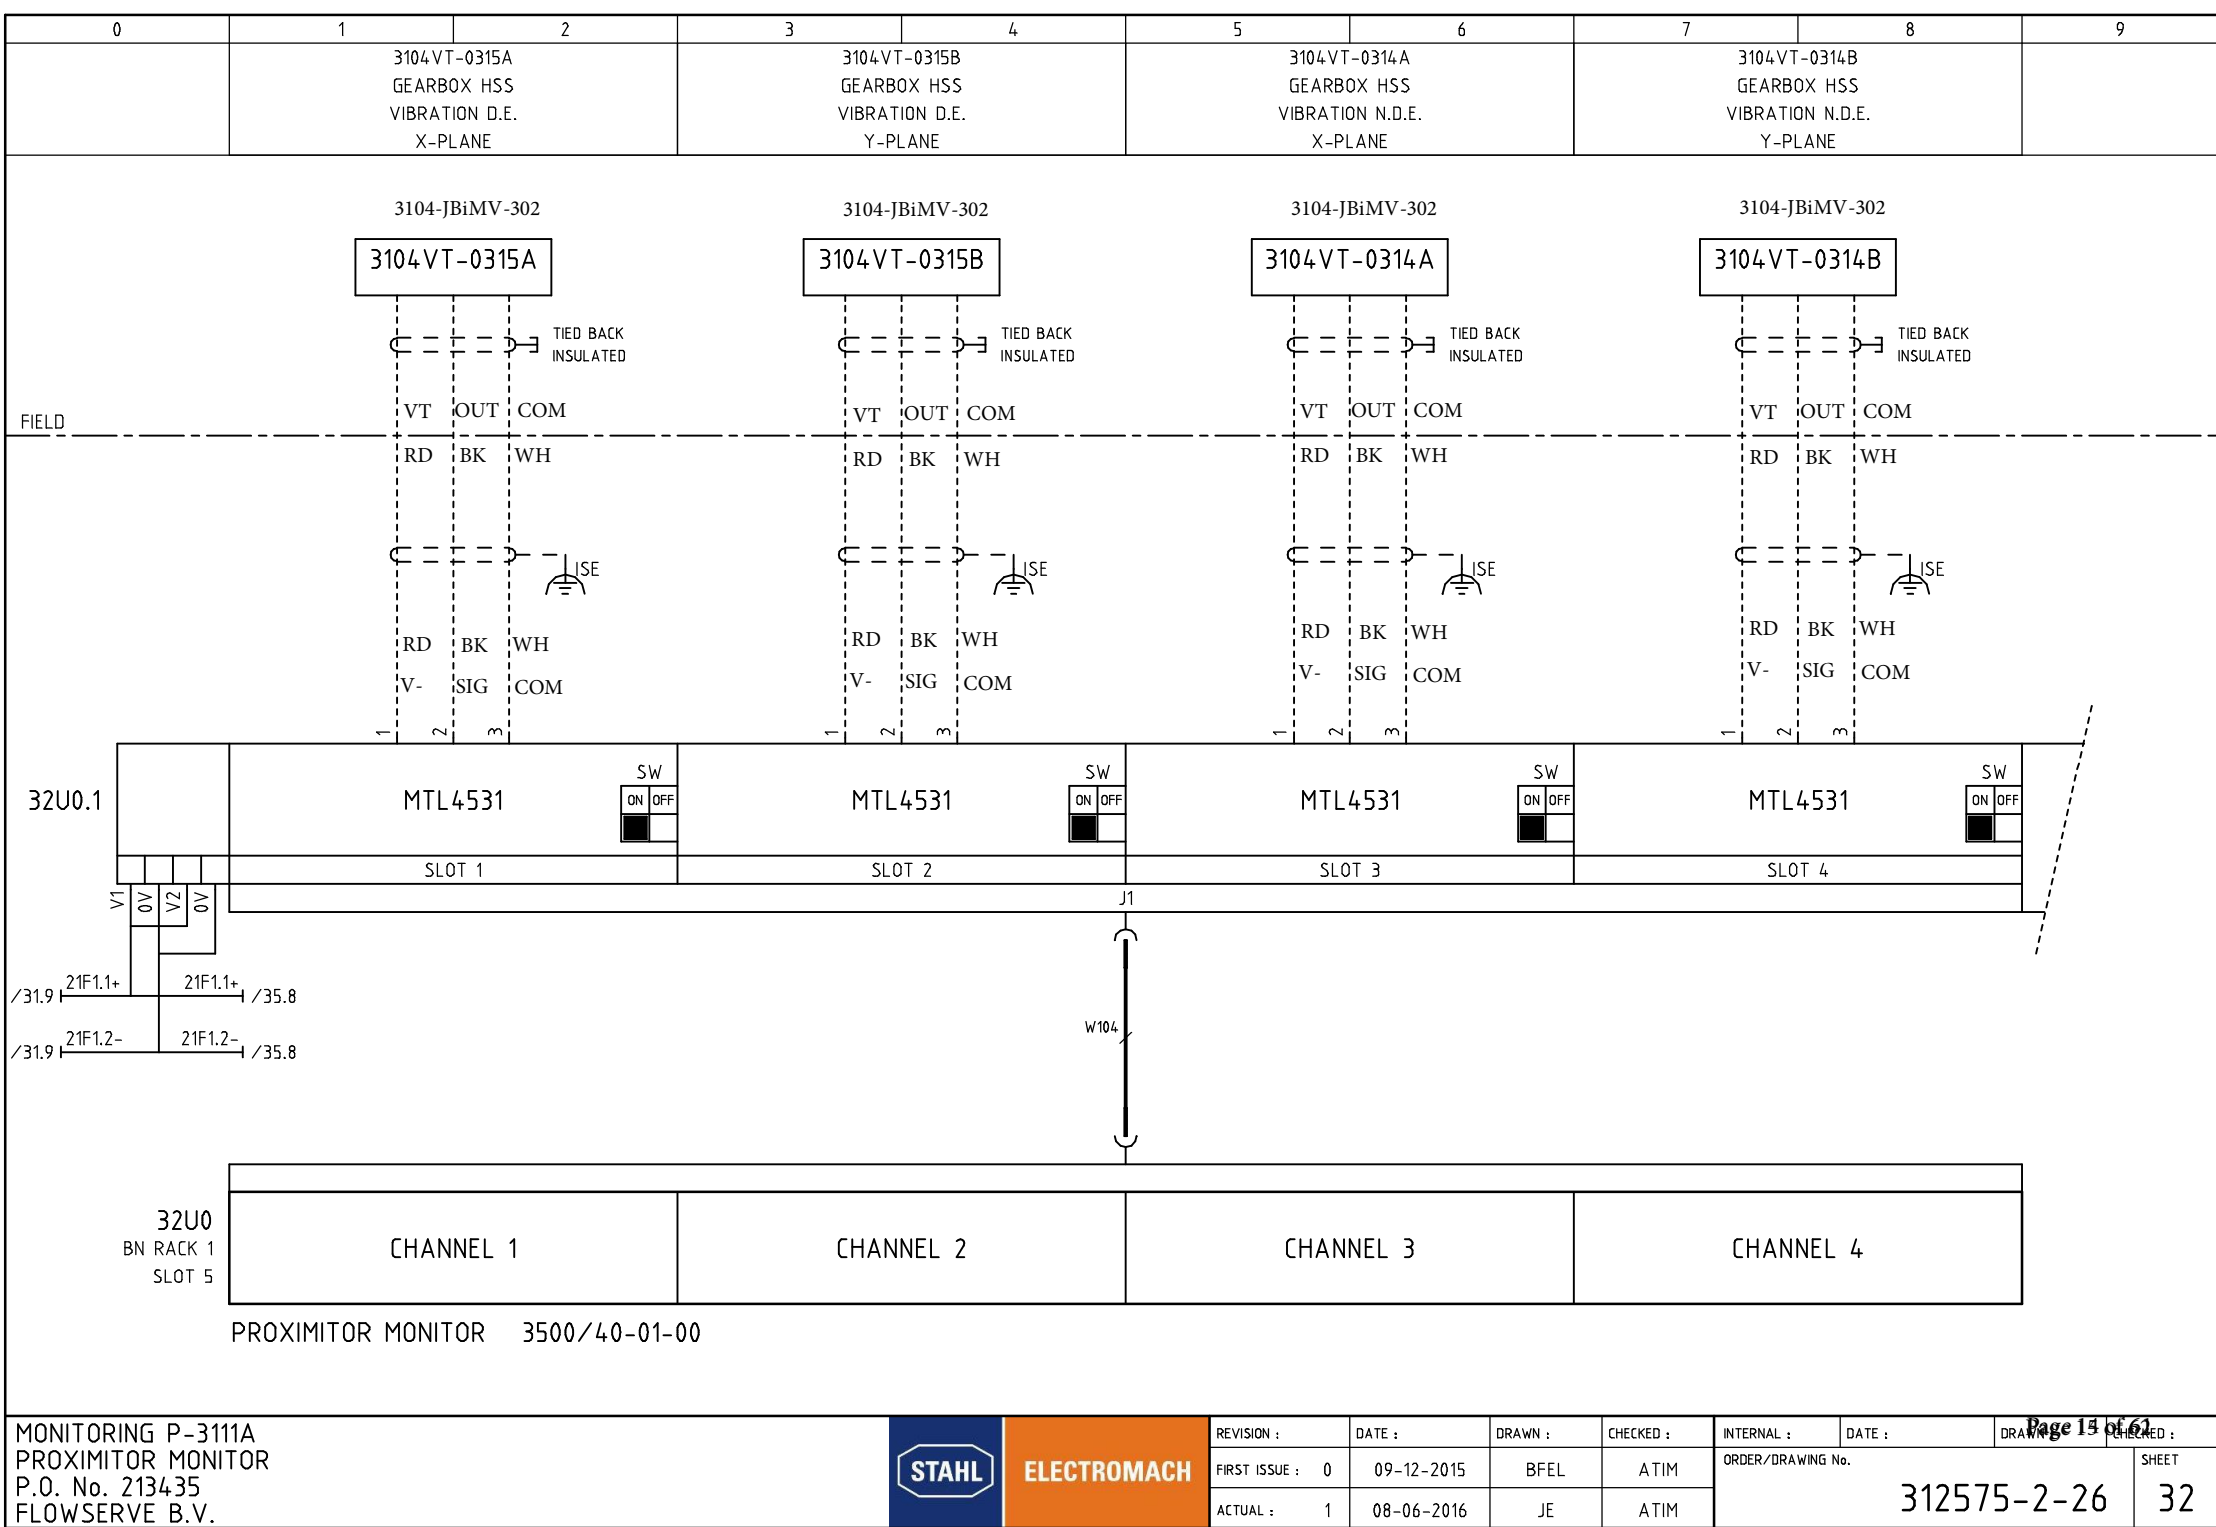

MTL4531

SW

ON

OFF

SLOT 3

MTL4531

SW

ON

OFF

SLOT 4

J1

W104

32U0

BN RACK 1

SLOT 5

CHANNEL 1

CHANNEL 2

CHANNEL 3

CHANNEL 4

PROXIMITOR MONITOR 3500/40-01-00

MONITORING P-3111A

PROXIMITOR MONITOR

P.O. No. 213435

FLOWERVE B.V.

STAHL

ELECTROMACH

REVISION :

DATE :

DRAWN :

CHECKED :

INTERNAL :

DATE :

DRAWN :

CHECKED :

FIRST ISSUE :

0

09-12-2015

BFEL

ATIM

ACTUAL :

1

08-06-2016

JE

ATIM


ORDER/DRAWING No.


312575-2-26

SHEET

32

Page 15 of 61

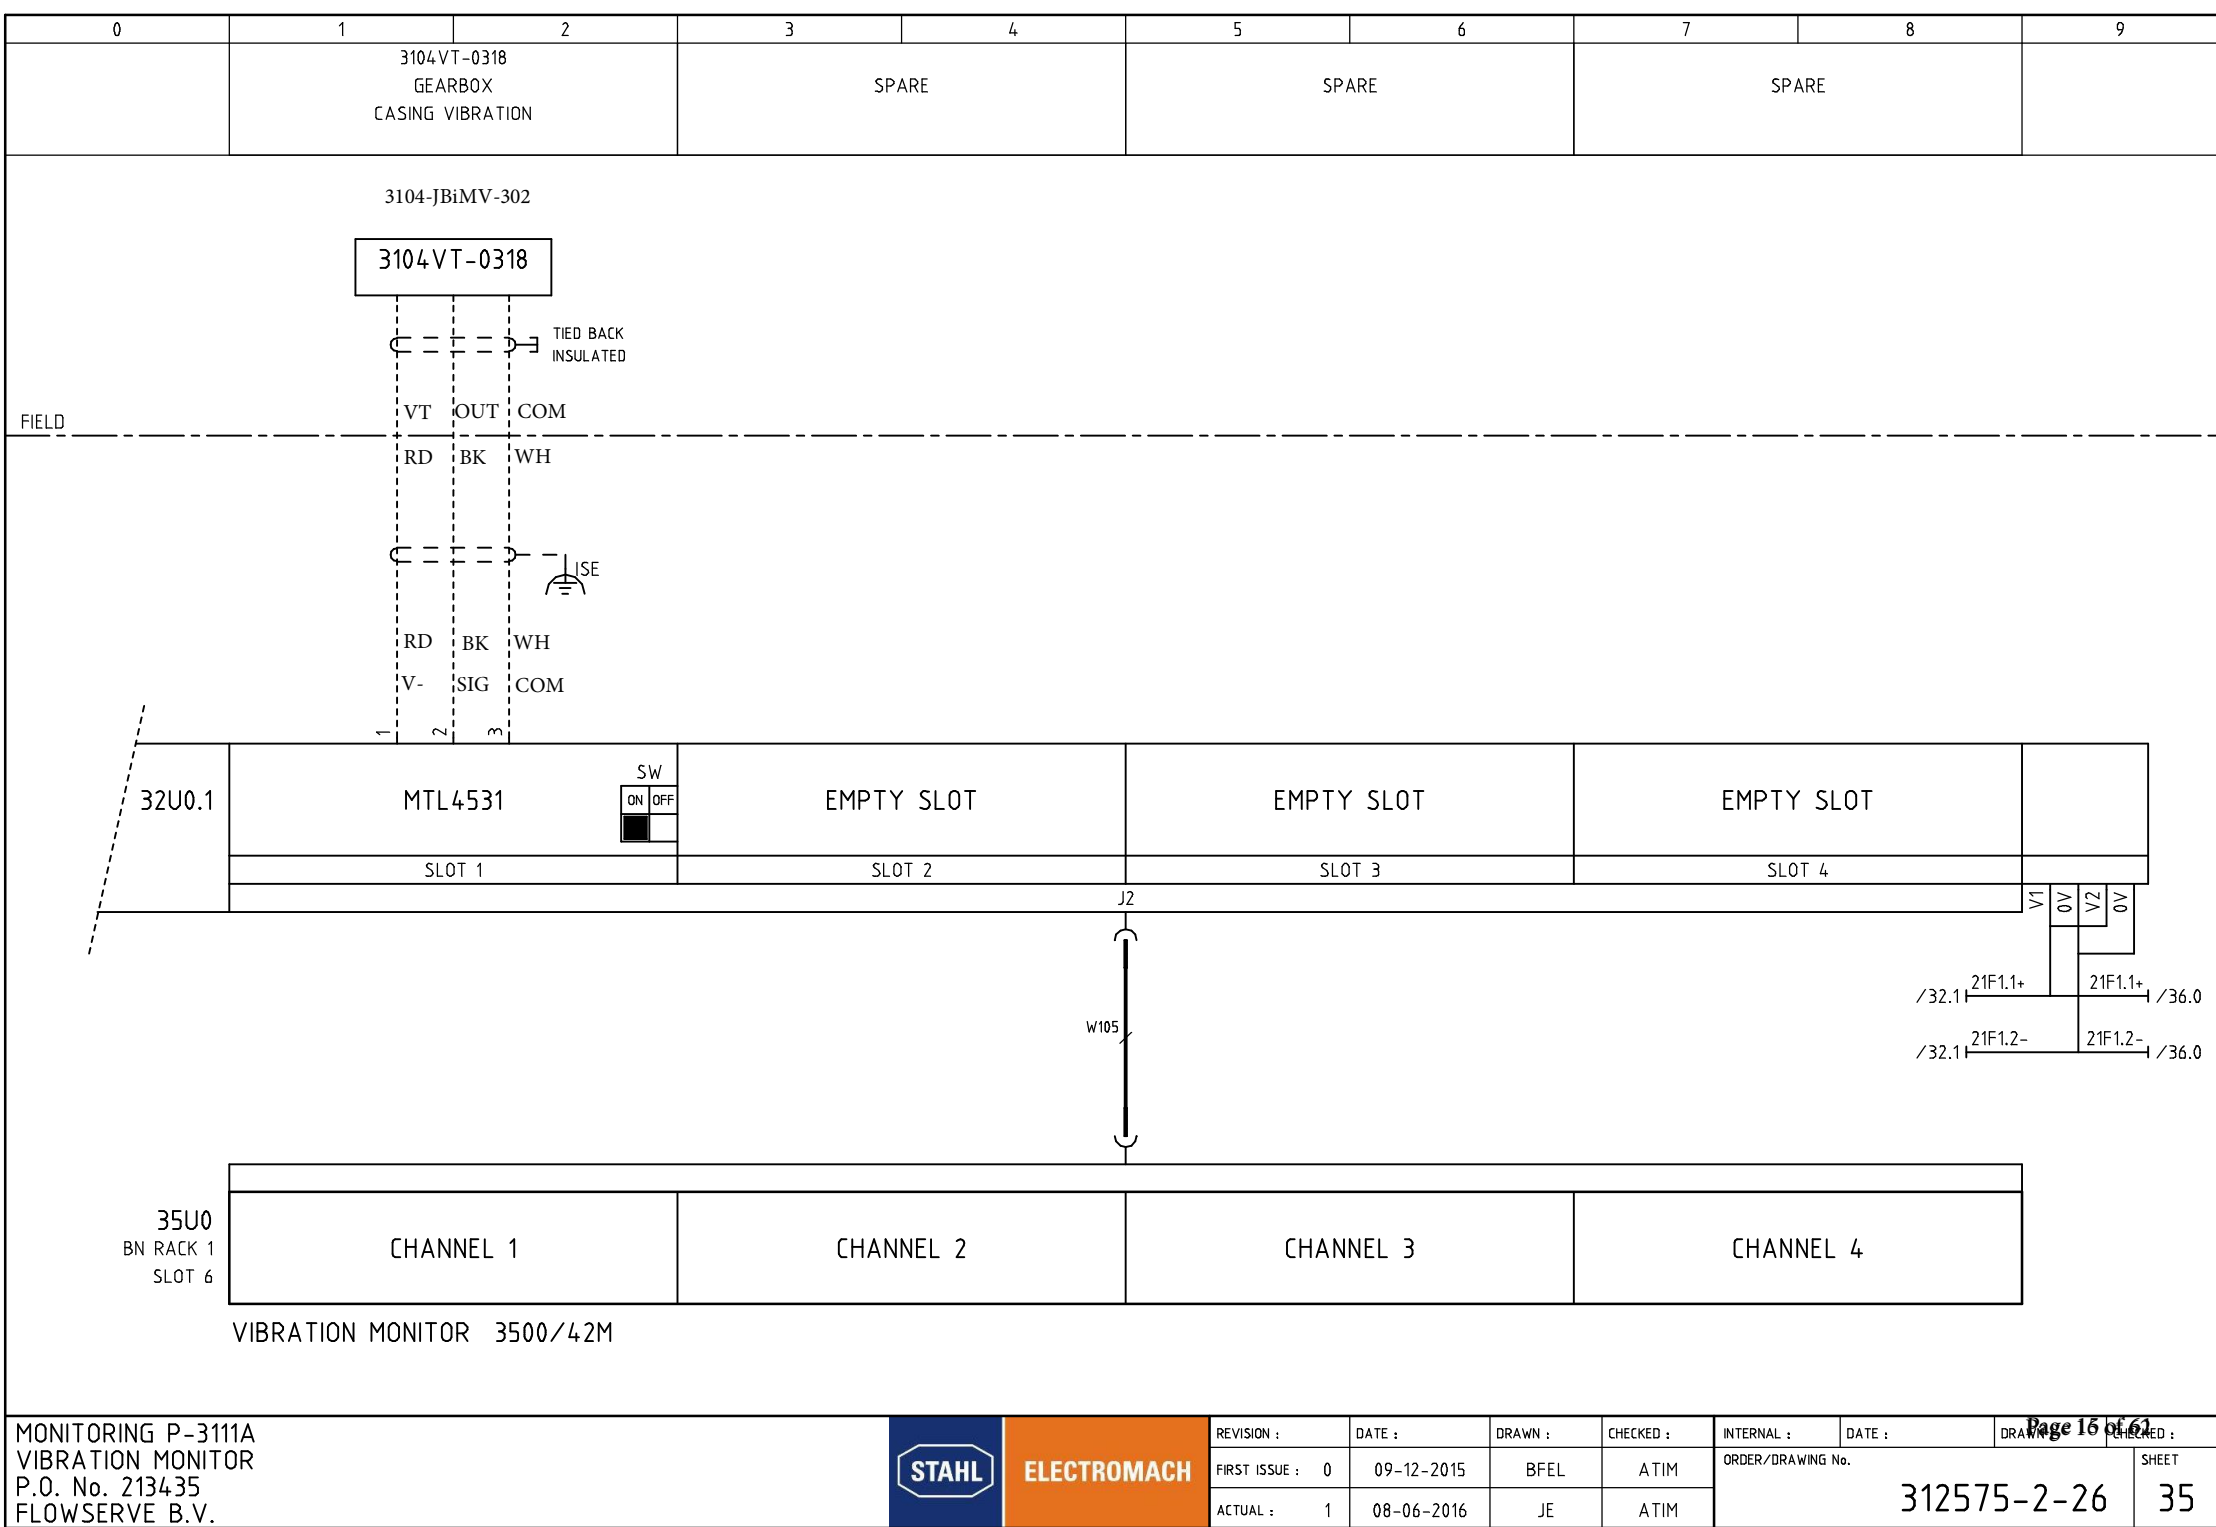

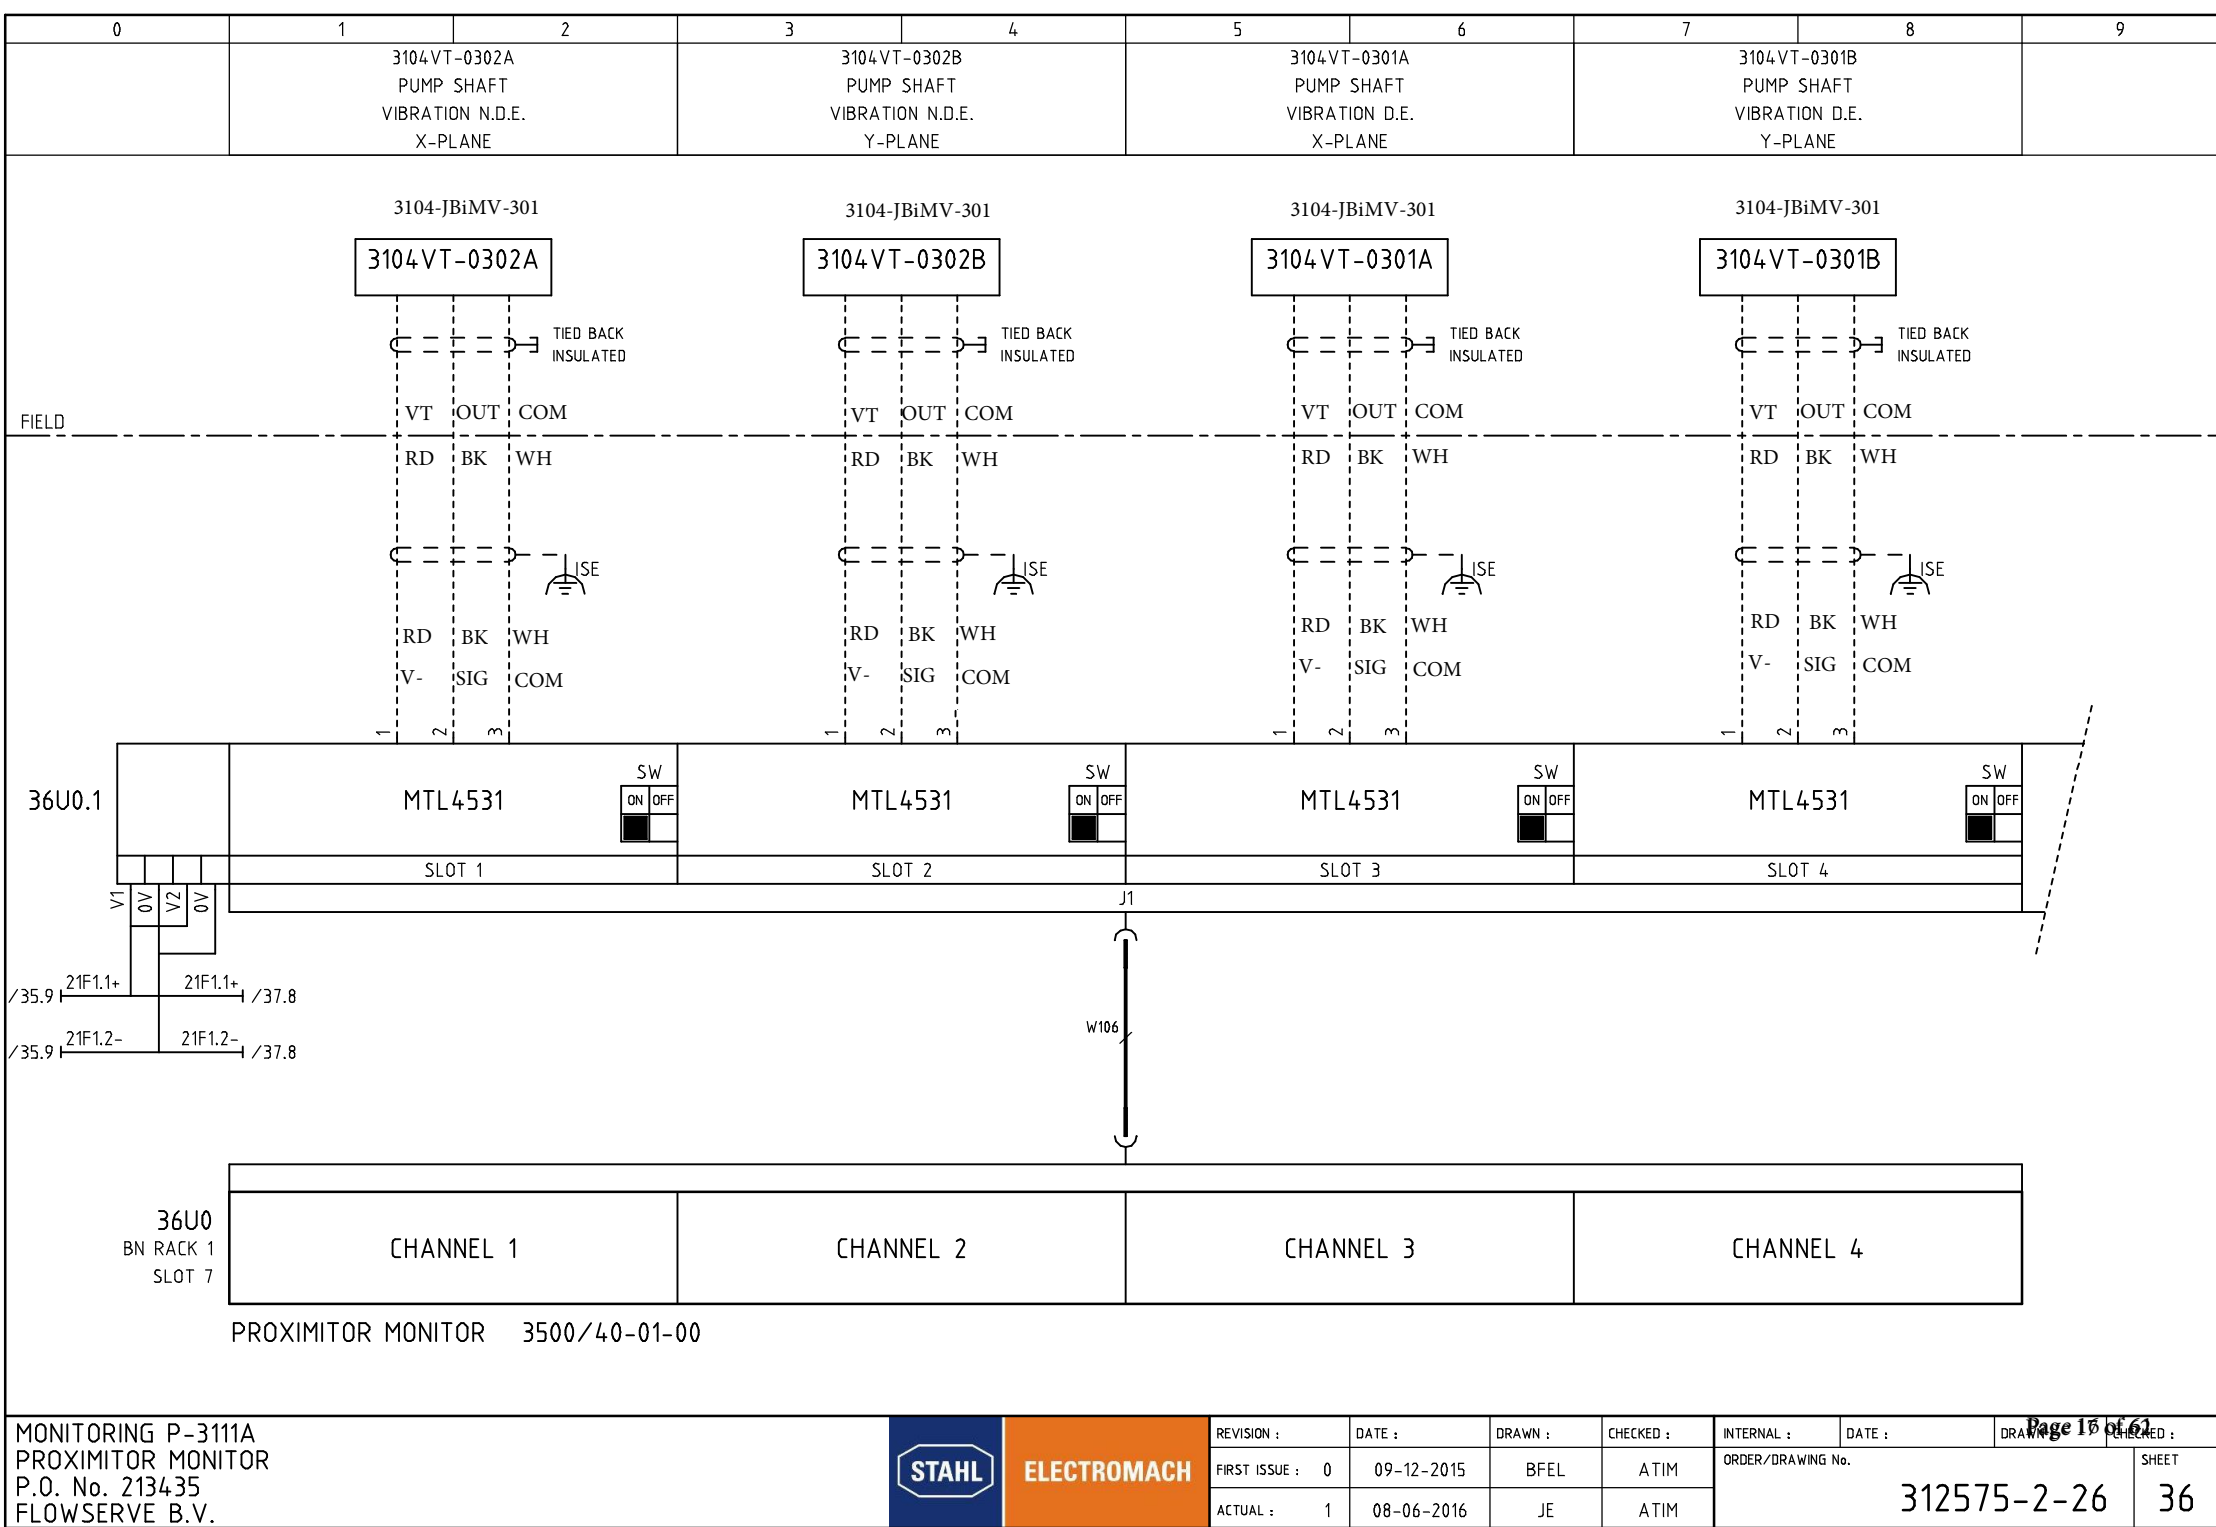

MTL4531

SW

ON

OFF

SLOT 3

MTL4531

SW

ON

OFF

SLOT 4

V1

OV

V2

OV

21F1.1+

21F1.1+

37.8

21F1.2-

21F1.2-

37.8

J1

W106

MONITORING P-3111A

PROXIMITOR MONITOR


P.O. No. 213435

FLOWERVE B.V.

STAHL

ELECTROMACH

Page 16 of 61

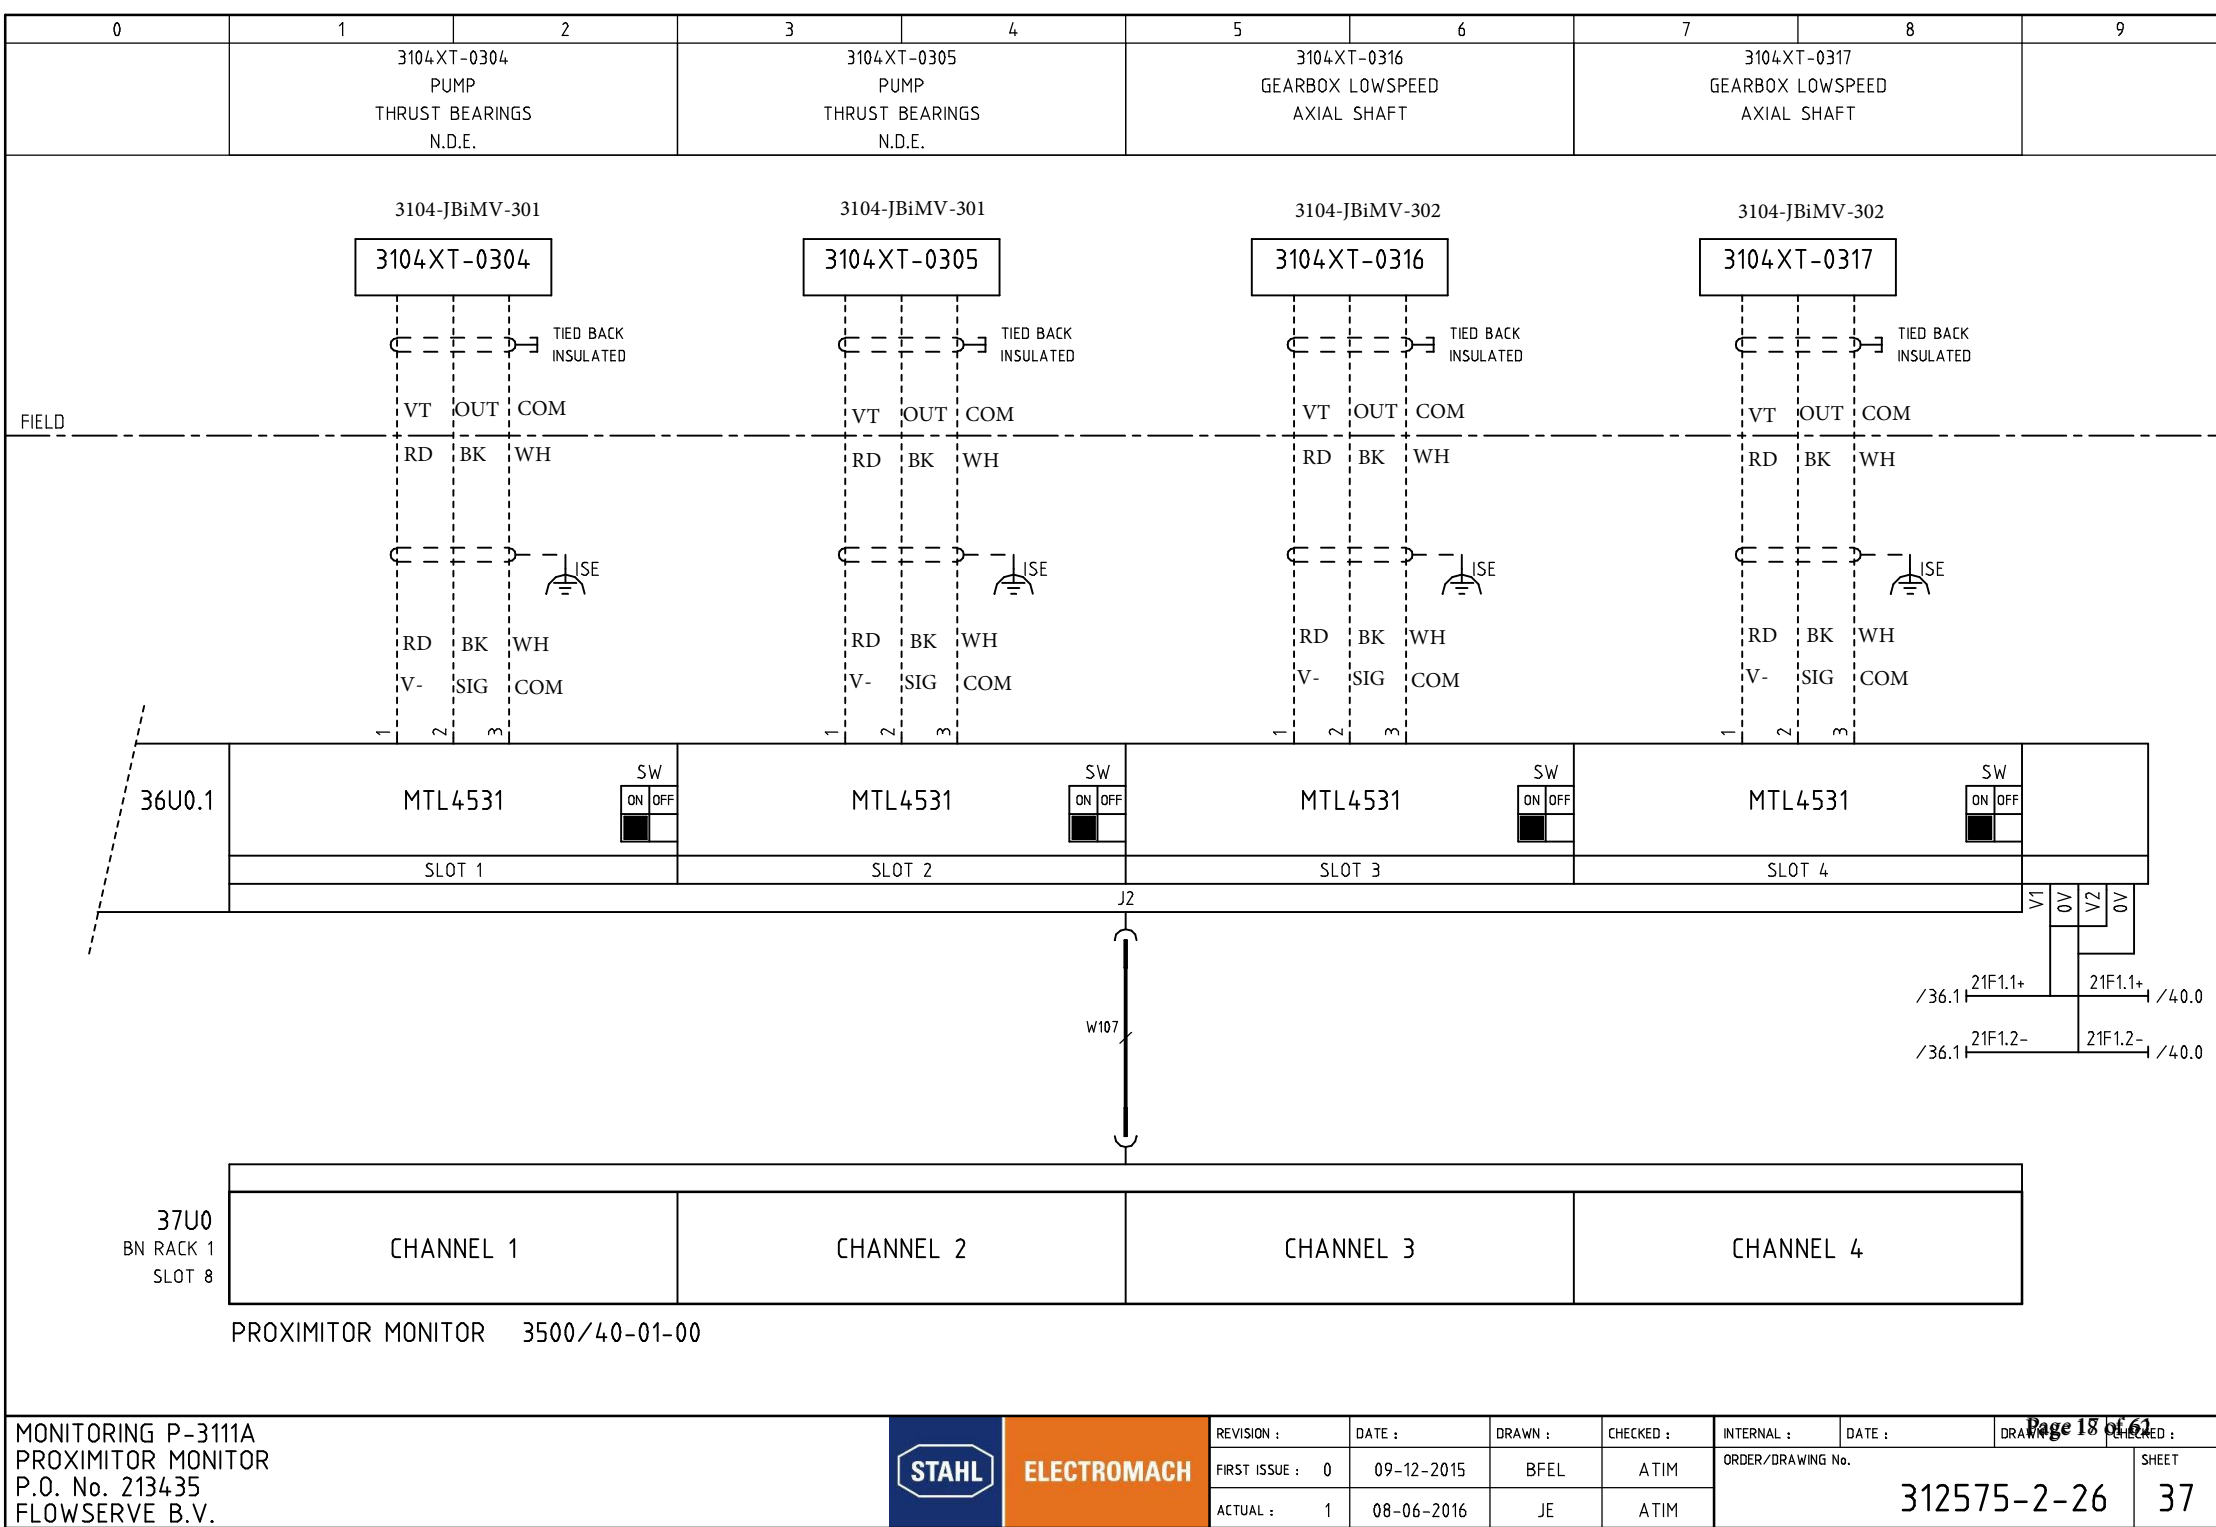

3104-JBiMV-302

3104XT-0316

VT

OUT

COM

RD

BK

WH

ISE

RD

BK

WH

V-

SIG

COM

123

TIED BACK
INSULATED

3104-JBiMV-302

3104XT-0317

VT

OUT

COM

RD

BK

WH

ISE

RD

BK

WH

V-

SIG

COM

123

TIED BACK
INSULATED

36U0.1

MTL4531

SW

ON

OFF

SLOT 1

MTL4531

SW

ON

OFF

SLOT 2

MTL4531

SW

ON

OFF

SLOT 3

MTL4531

SW

ON

OFF

SLOT 4

J2

W107

V1

0V

V2

0V

21F1.1+

21F1.2-

36.1

40.0

37U0

BN RACK 1

SLOT 8


CHANNEL 1

CHANNEL 2

CHANNEL 3

CHANNEL 4

PROXIMITOR MONITOR 3500/40-01-00

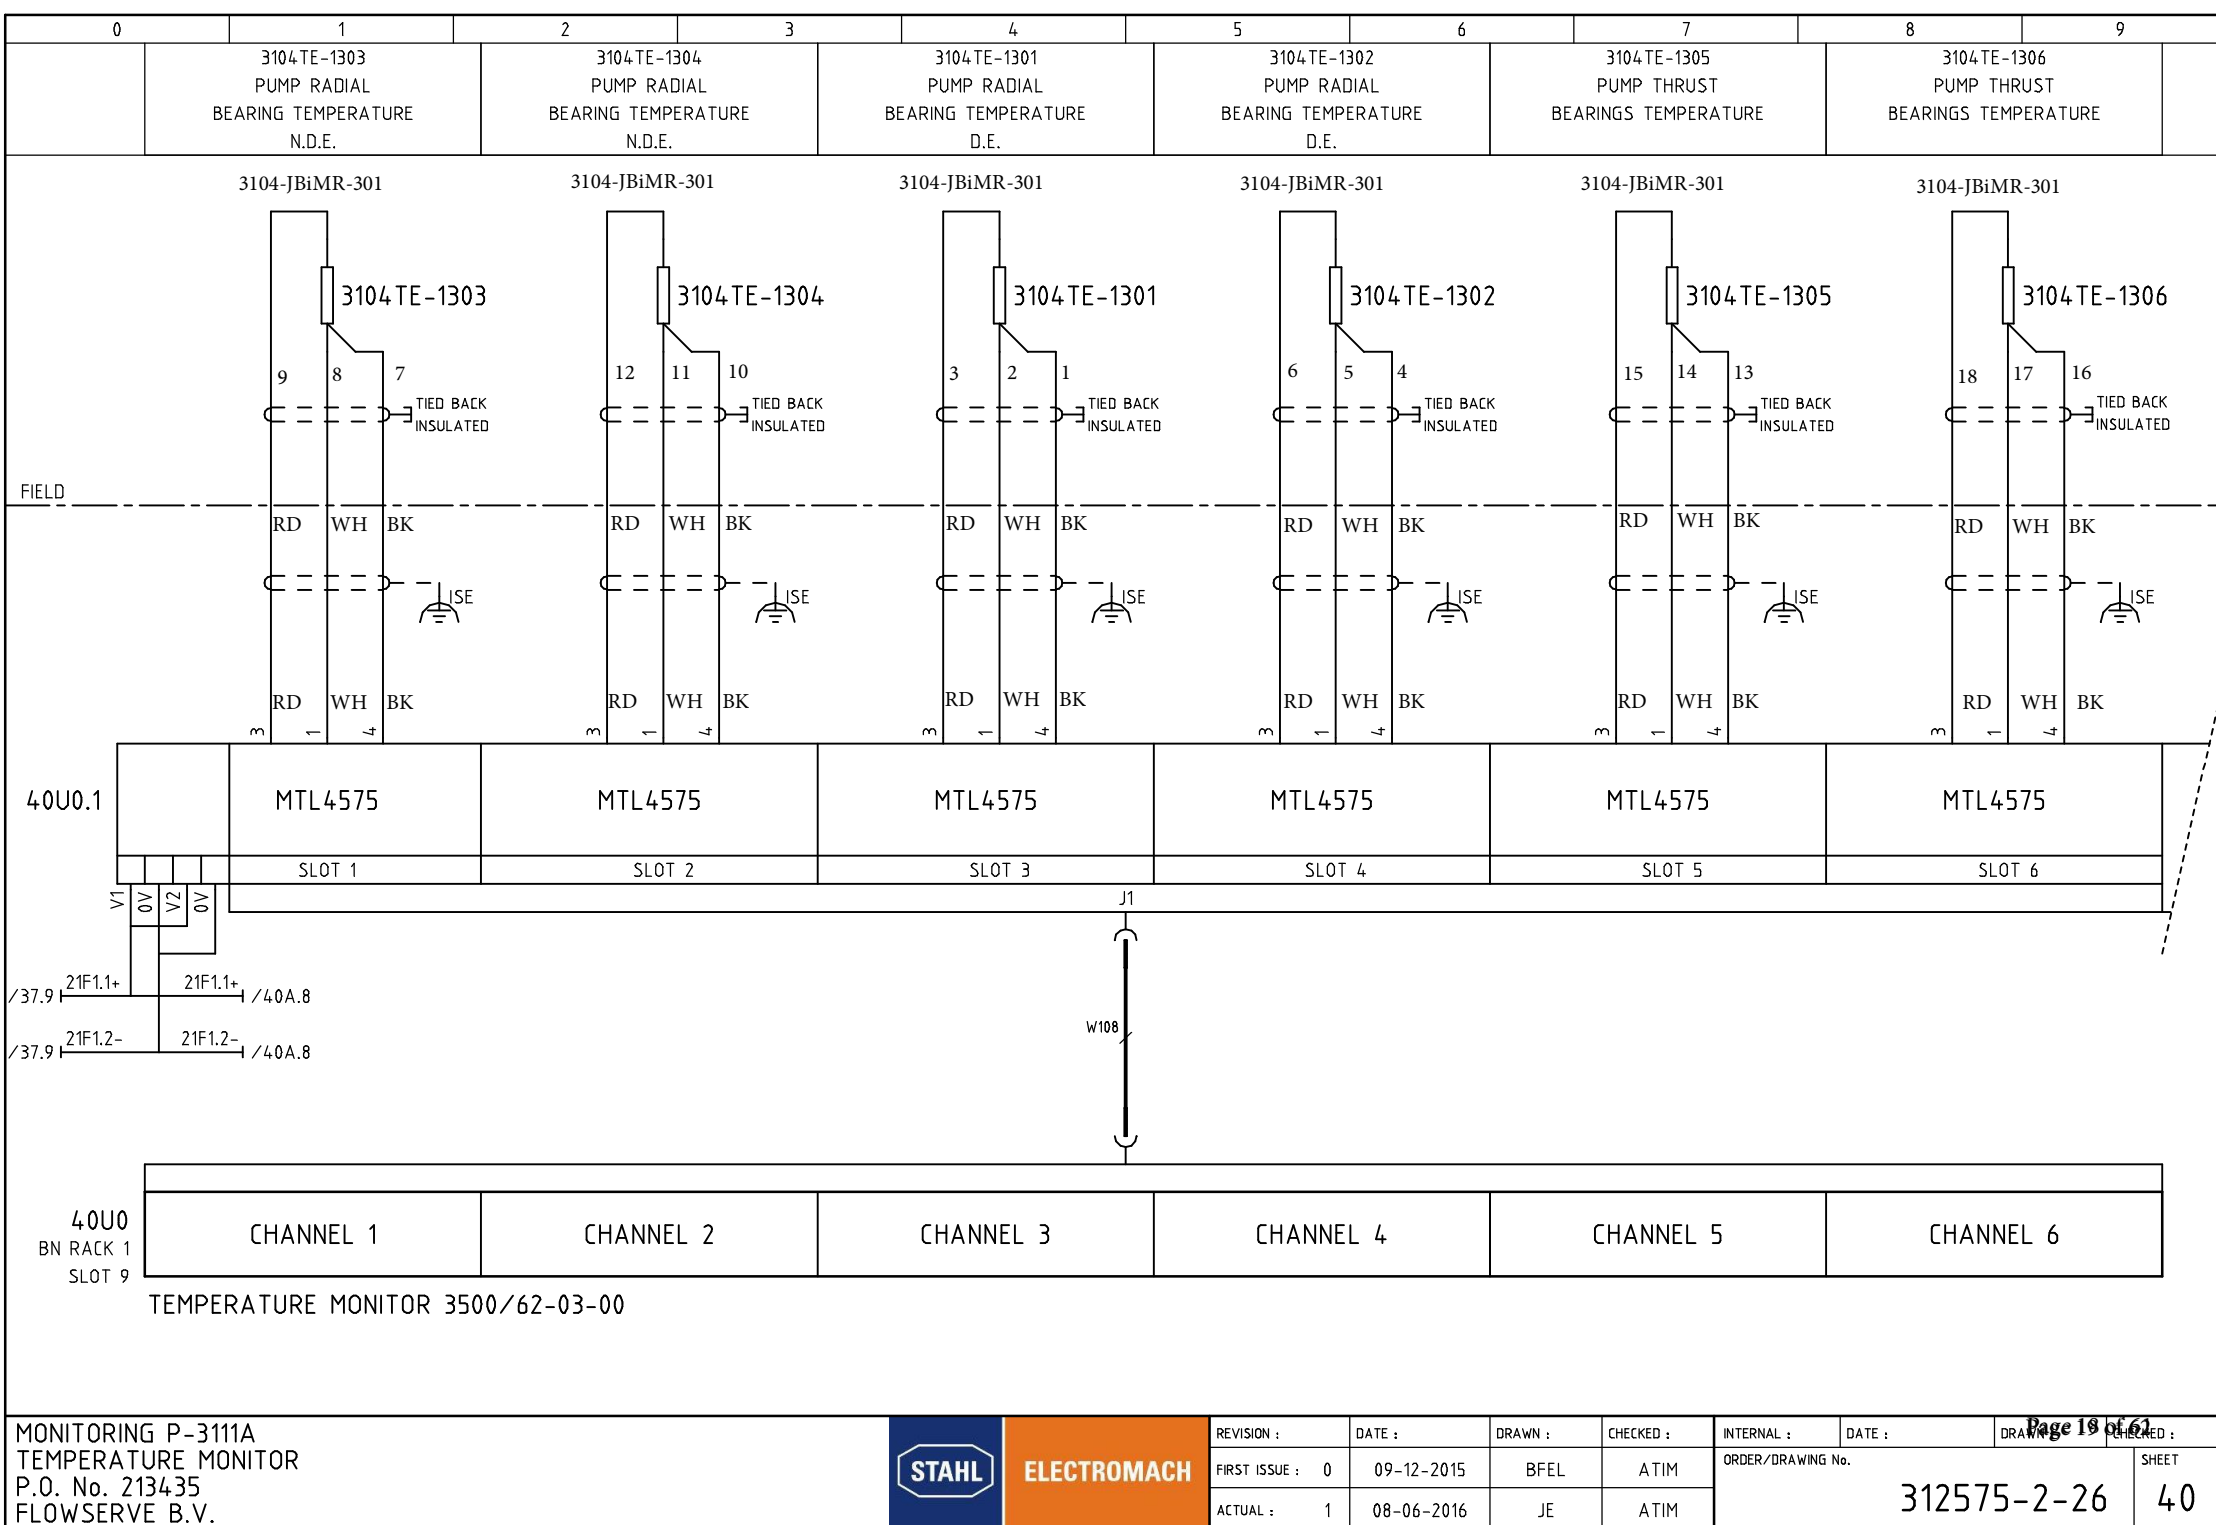

MONITORING P-3111A

TEMPERATURE MONITOR

P.O. No. 213435

FLOWERVE B.V.

STAHL

ELECTROMACH

REVISION :

DATE :

DRAWN :

CHECKED :

INTERNAL :

DATE :

DRAWN :

CHECKED :

FIRST ISSUE : 0

09-12-2015

BFEL

ATIM


ORDER/DRAWING No.


312575-2-26

SHEET

40

0	1	2	3	4	5	6	7	8	9

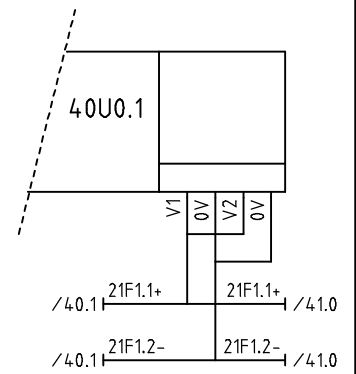

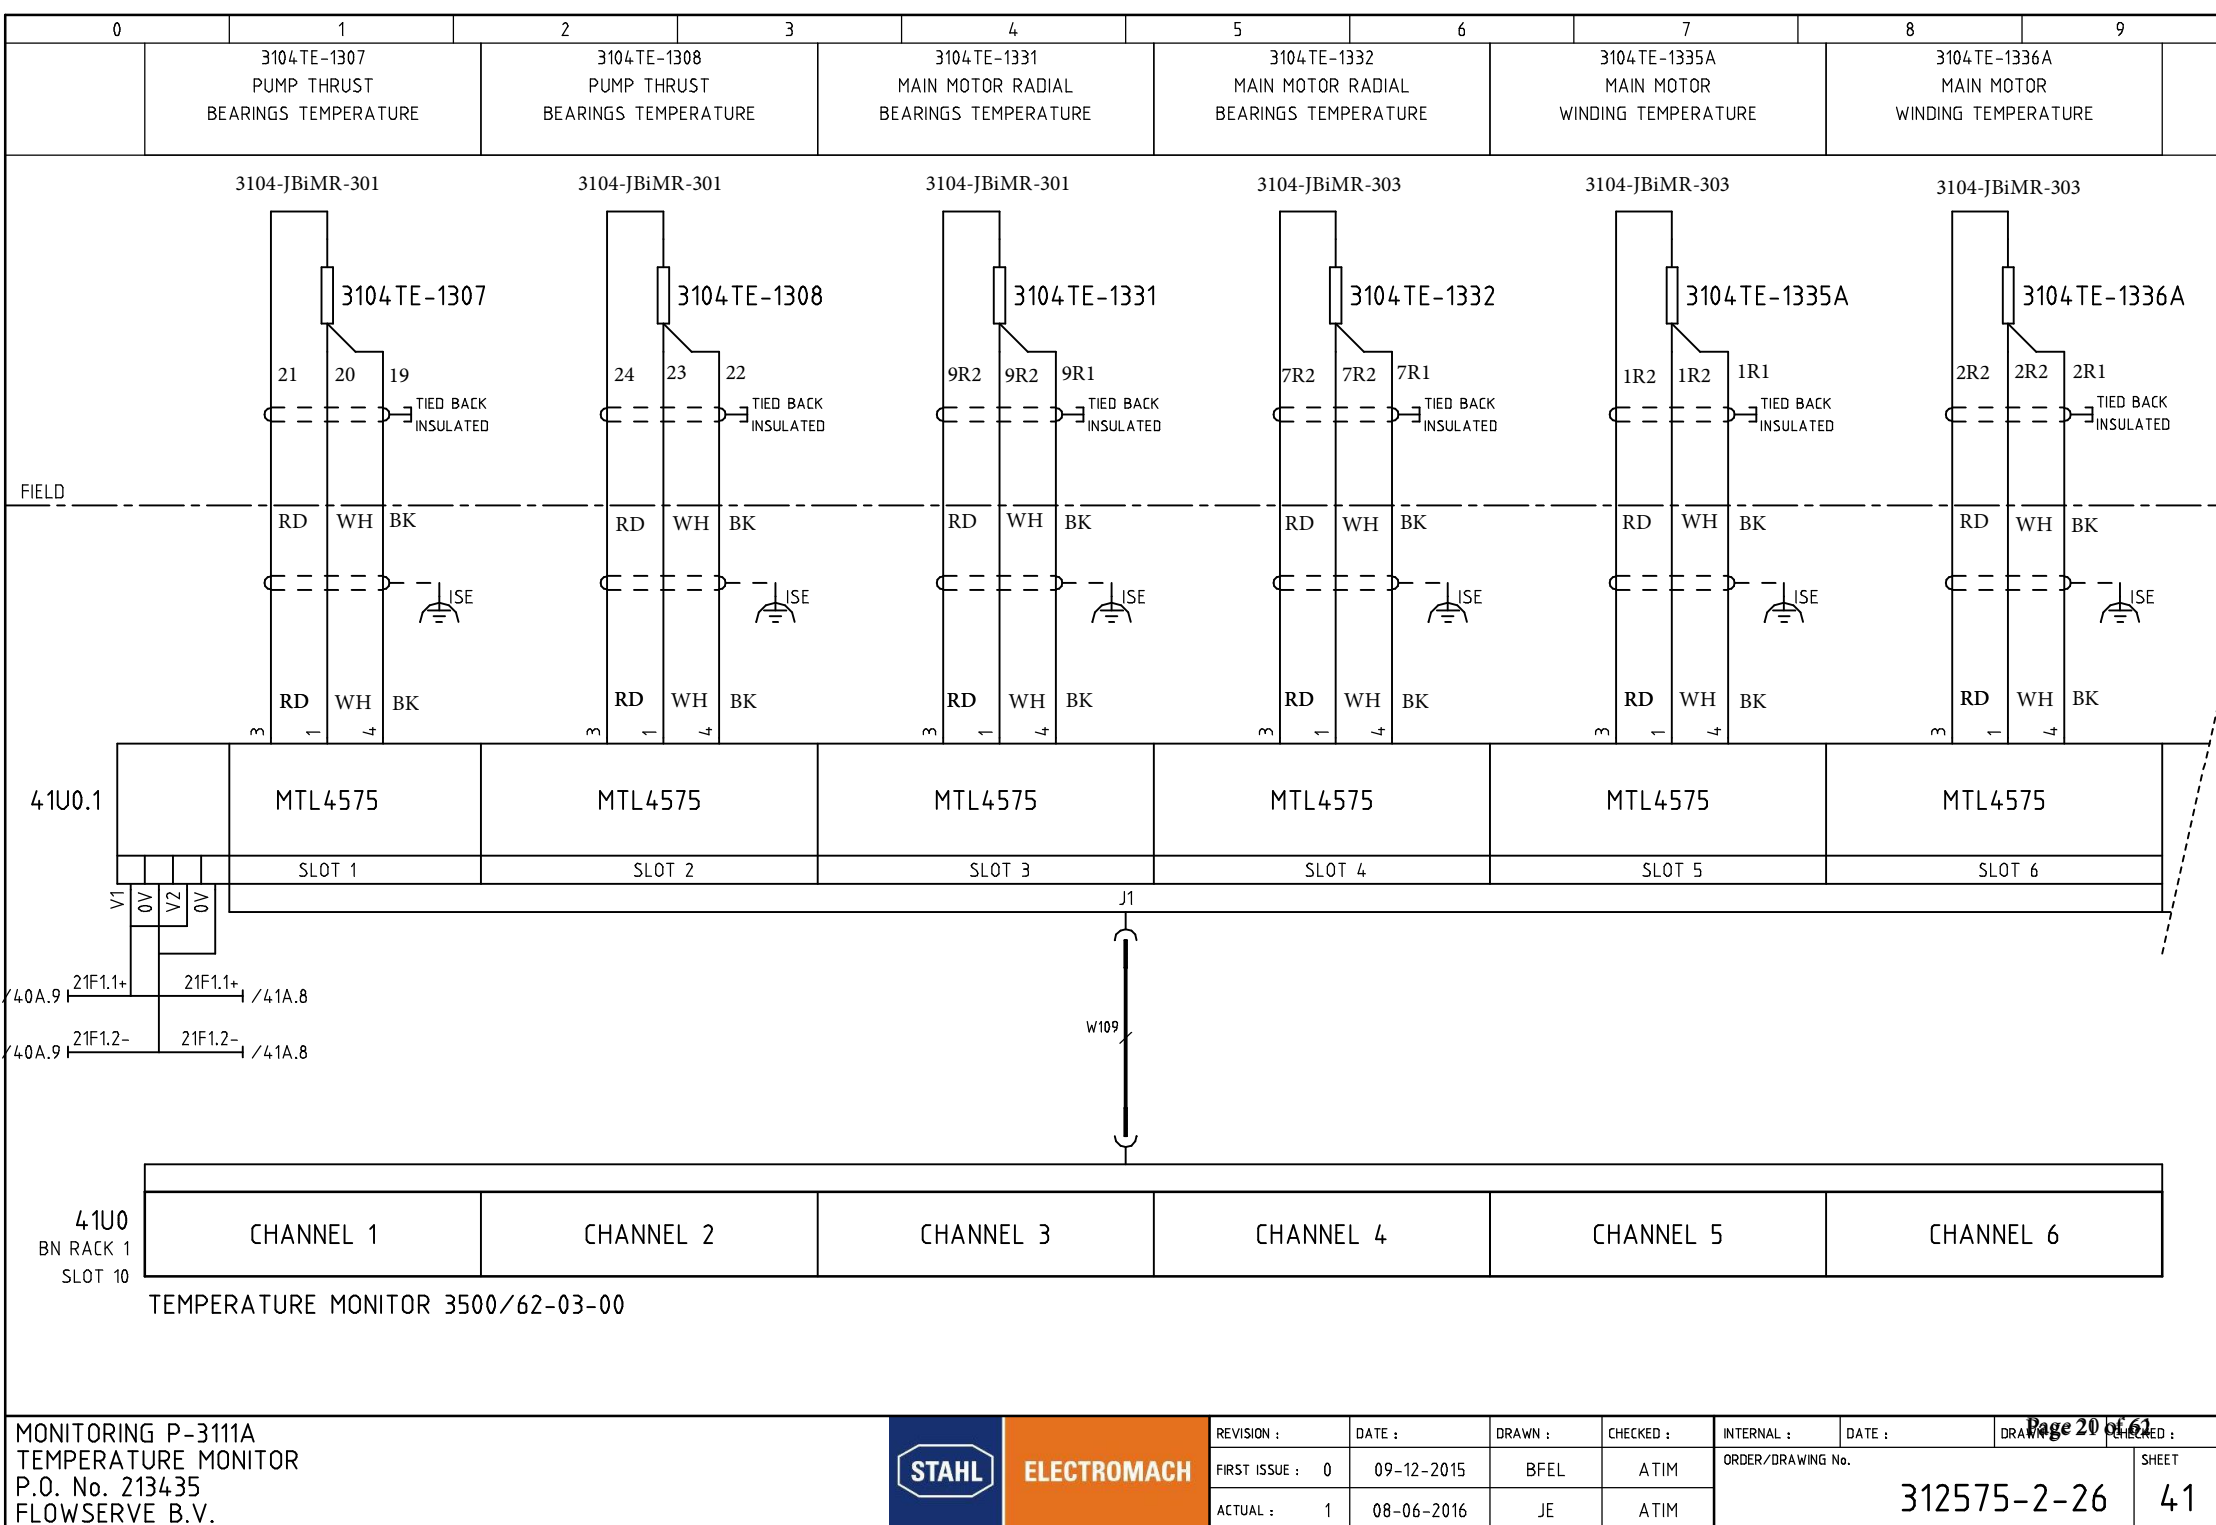

MONITORING P-3111A

TEMPERATURE MONITOR

P.O. No. 213435

FLOWERVE B.V.

STAHL

ELECTROMACH

REVISION :

DATE :

DRAWN :

CHECKED :

INTERNAL :

DATE :

DRAWN :

CHECKED :

FIRST ISSUE : 0

09-12-2015

BFEL

ATIM

ORDER/DRAWING No.


312575-2-26

SHEET


41


Page 20 of 61

0	1	2	3	4	5	6	7	8	9

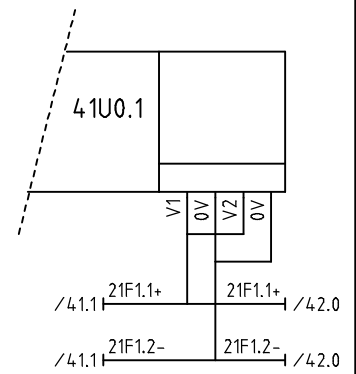



0	1	2	3	4	5	6	7	8	9

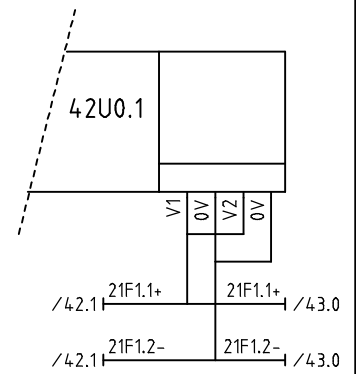

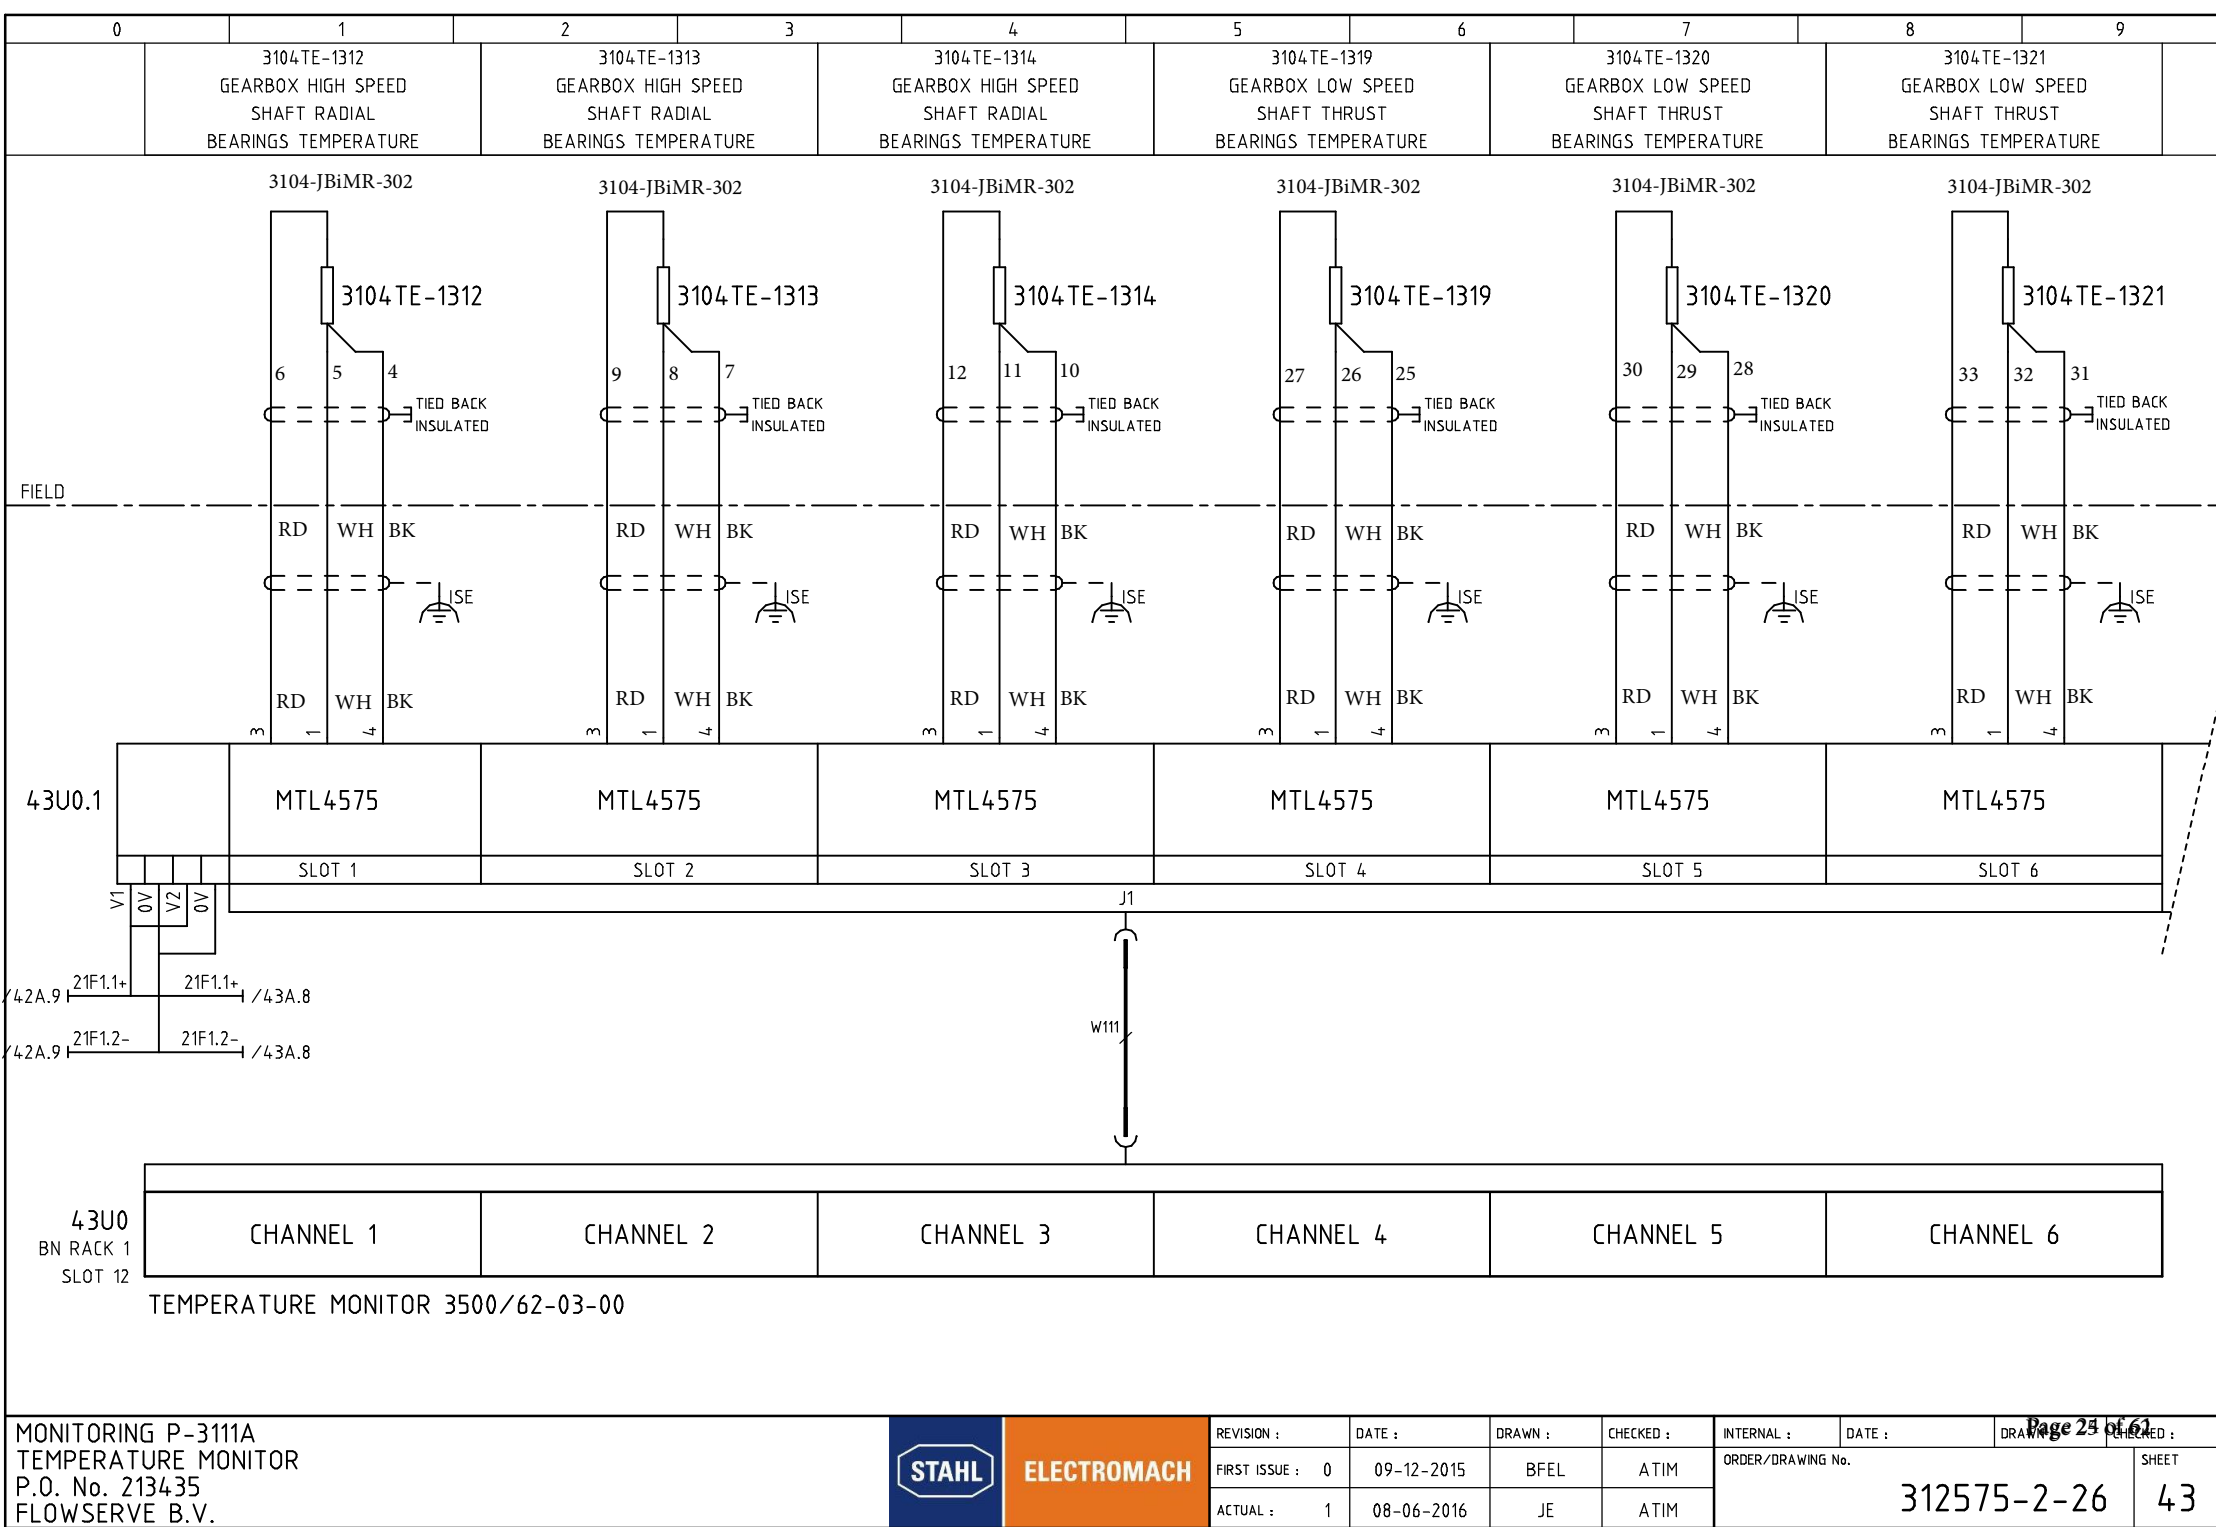


0	1	2	3	4	5	6	7	8	9

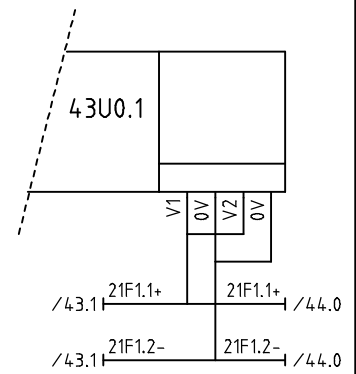

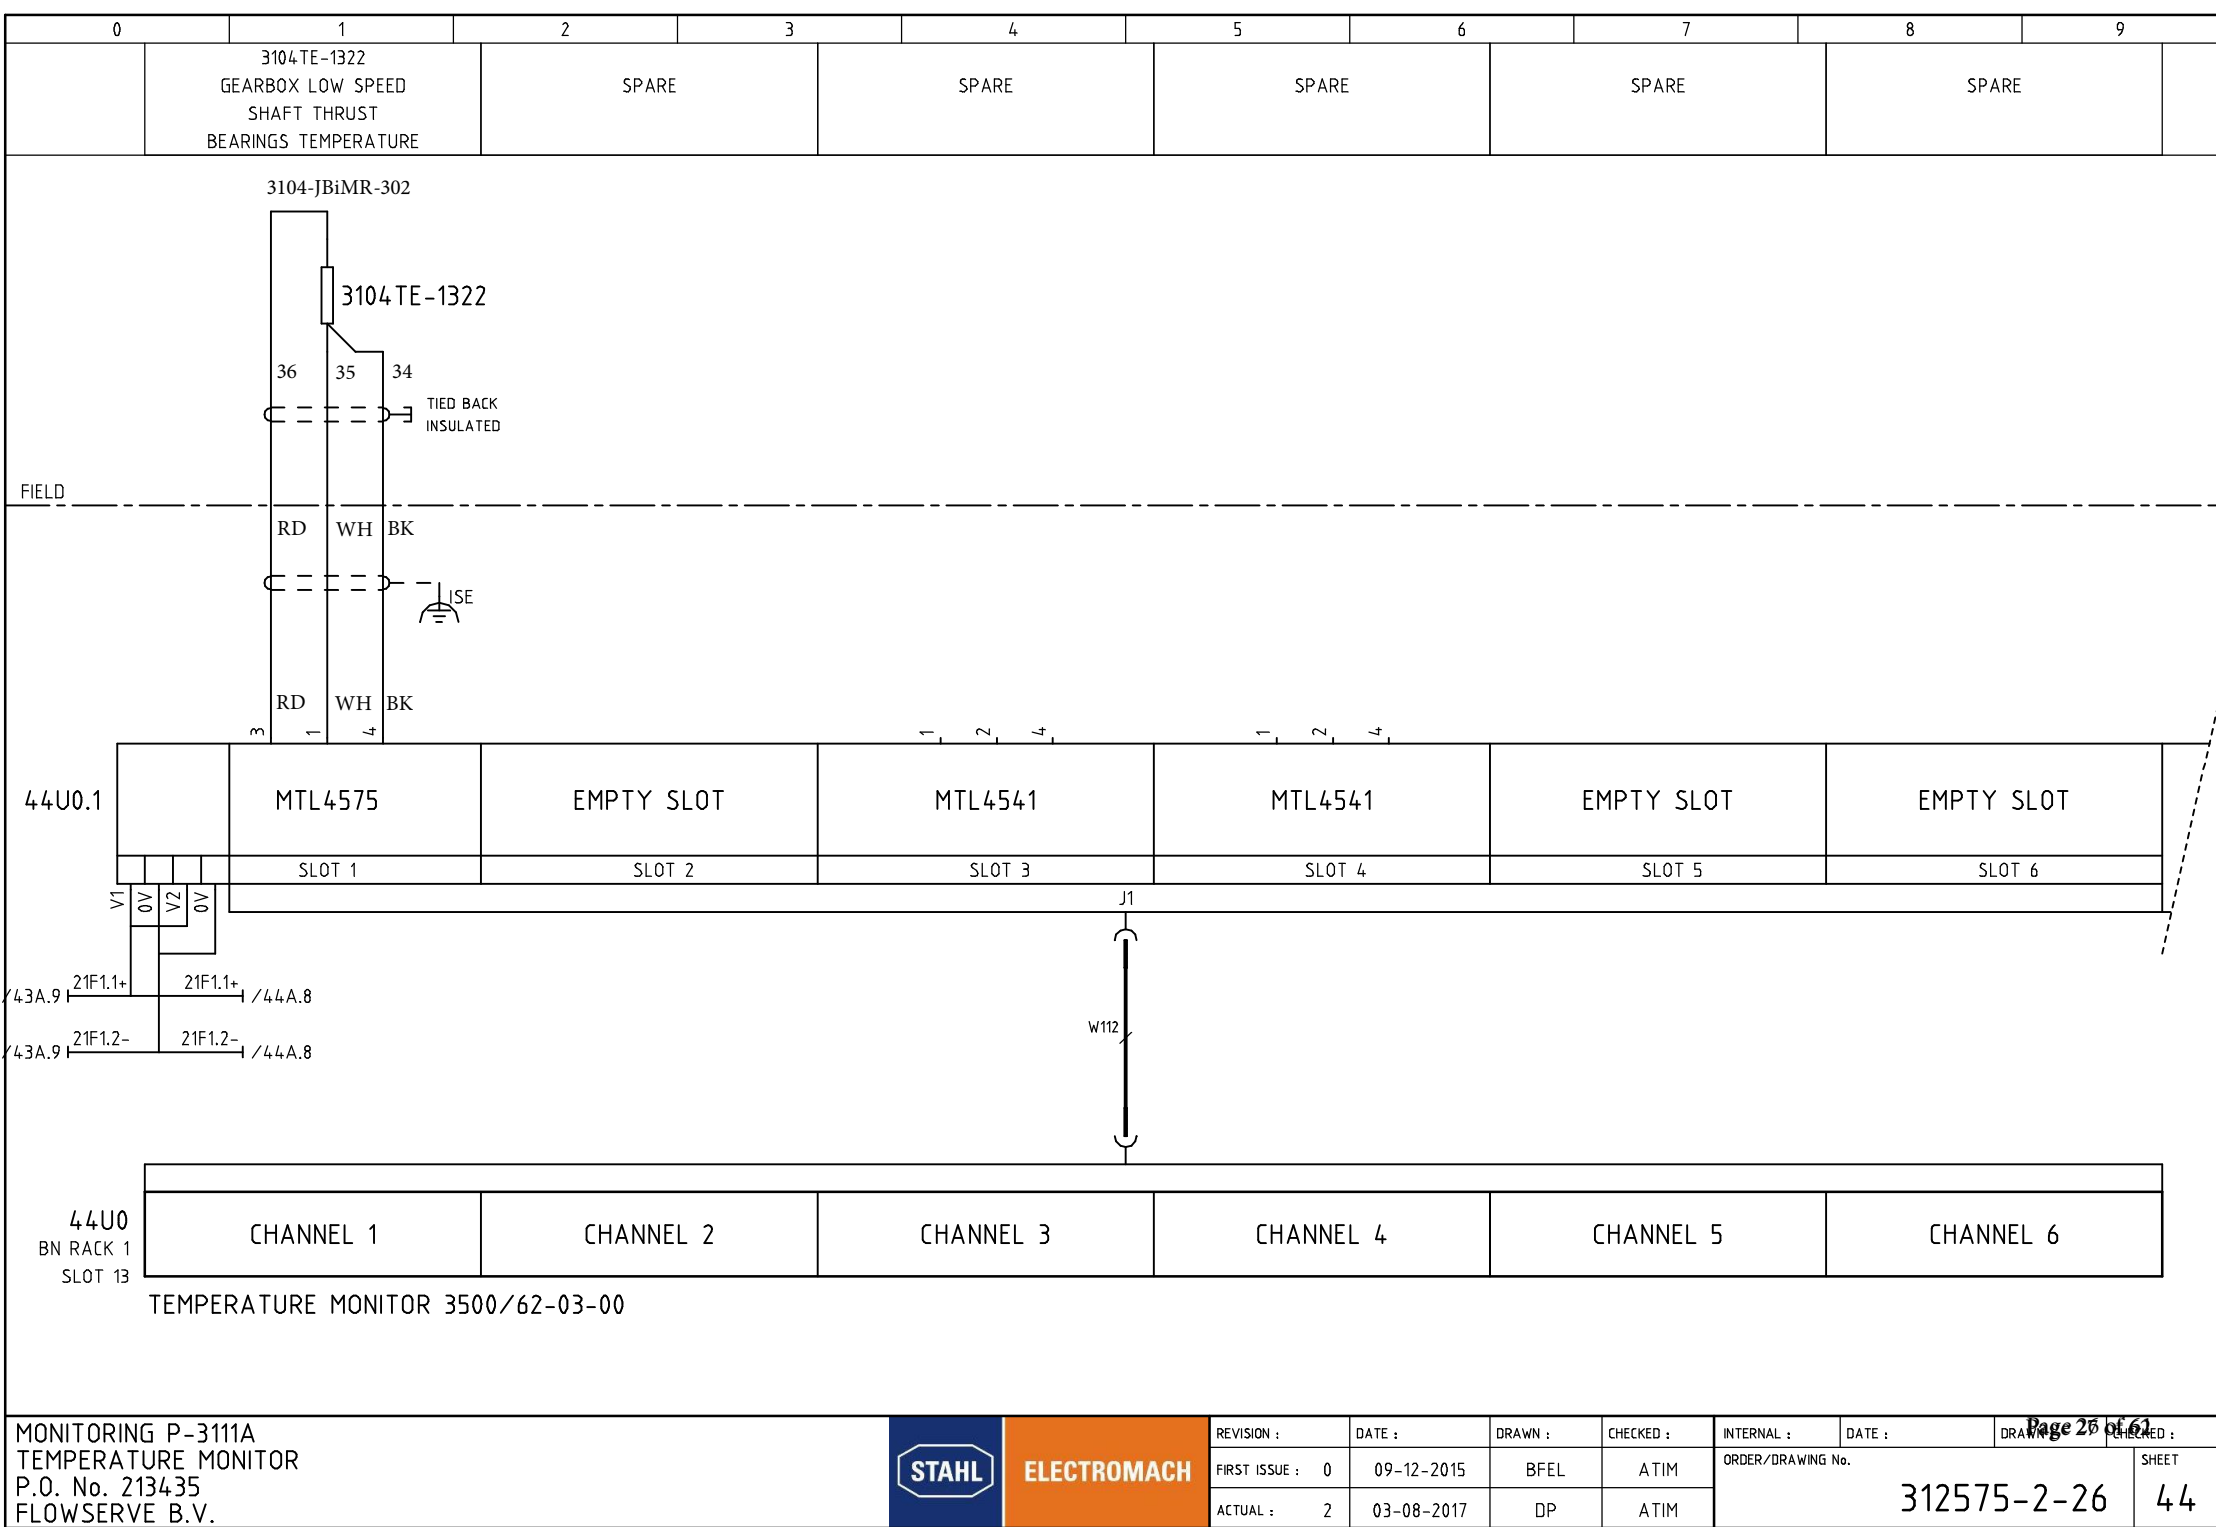



0	1	2	3	4	5	6	7	8	9

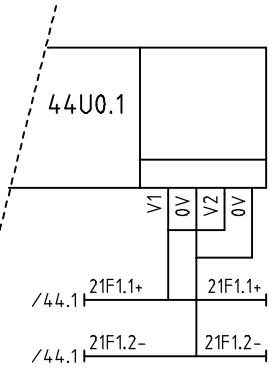


0	1	2	3	4	5	6	7	8	9
	3104XS-0329 COMMON TRIP VIBRATION 3100Z-113A		3104XS-0330 COMMON TEMPERATURE MEASUREMENT 3100Z-113A		3104XS-0328 COMMON TRIP AXIAL DISPLACEMENT 3100Z-113A		SPARE		

RELAY MODULE 3500/32-01-00


47U1
BN RACK 1
SLOT 14

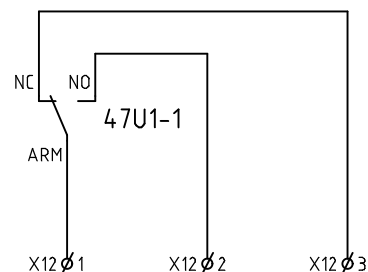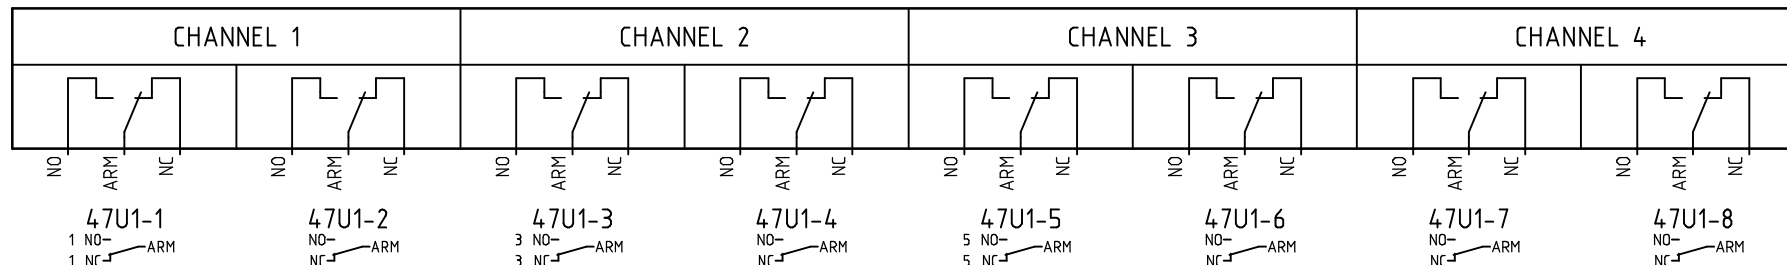

3104XS-0329

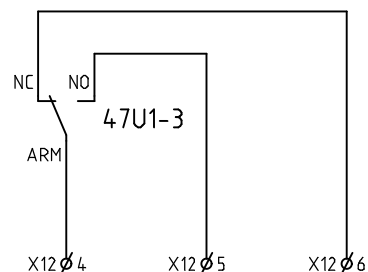

3104XS-0330

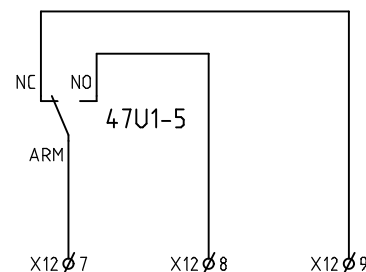

3104XS-0328

0	1	2	3	4	5	6	7	8	9
	MODBUS TCP/IP				SPARE				

COMMUNICATION GATEWAY 3500/92-04-01-00



48U1
BN RACK 1
SLOT 15

ETHERNET
10/100 BASE-T
RJ-45
IP ADDRESS :
192.168.0.9

W113

BN
RACK 1
/21.2


RS485
MODBUS

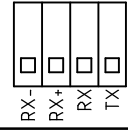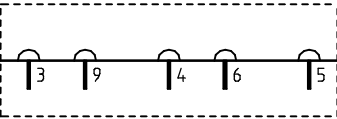

SLAVE
ADDRESS

RACK INTERFACE MODULE 3500/22M-01-01-00

60U1
BN RACK 2
SLOT 1

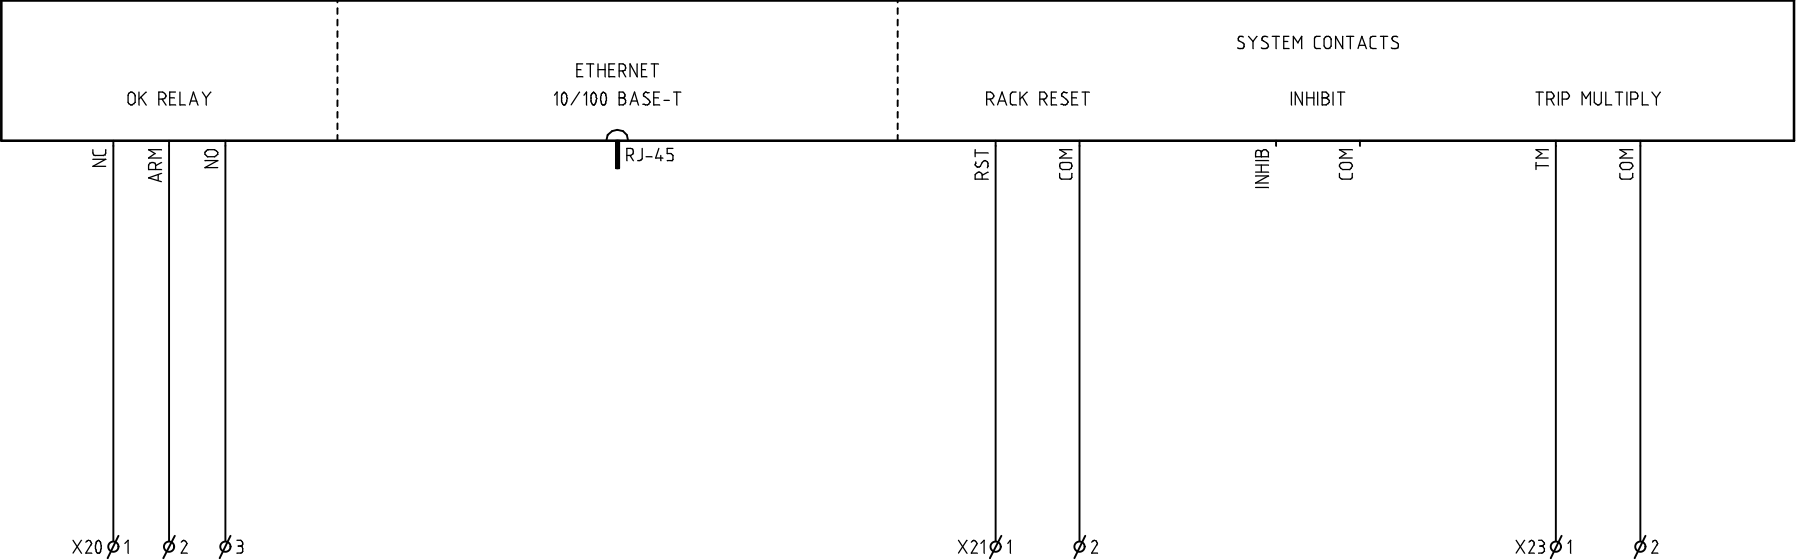


EXTERNAL


3104XS-0440


3104XY-0441


3104XY-0442

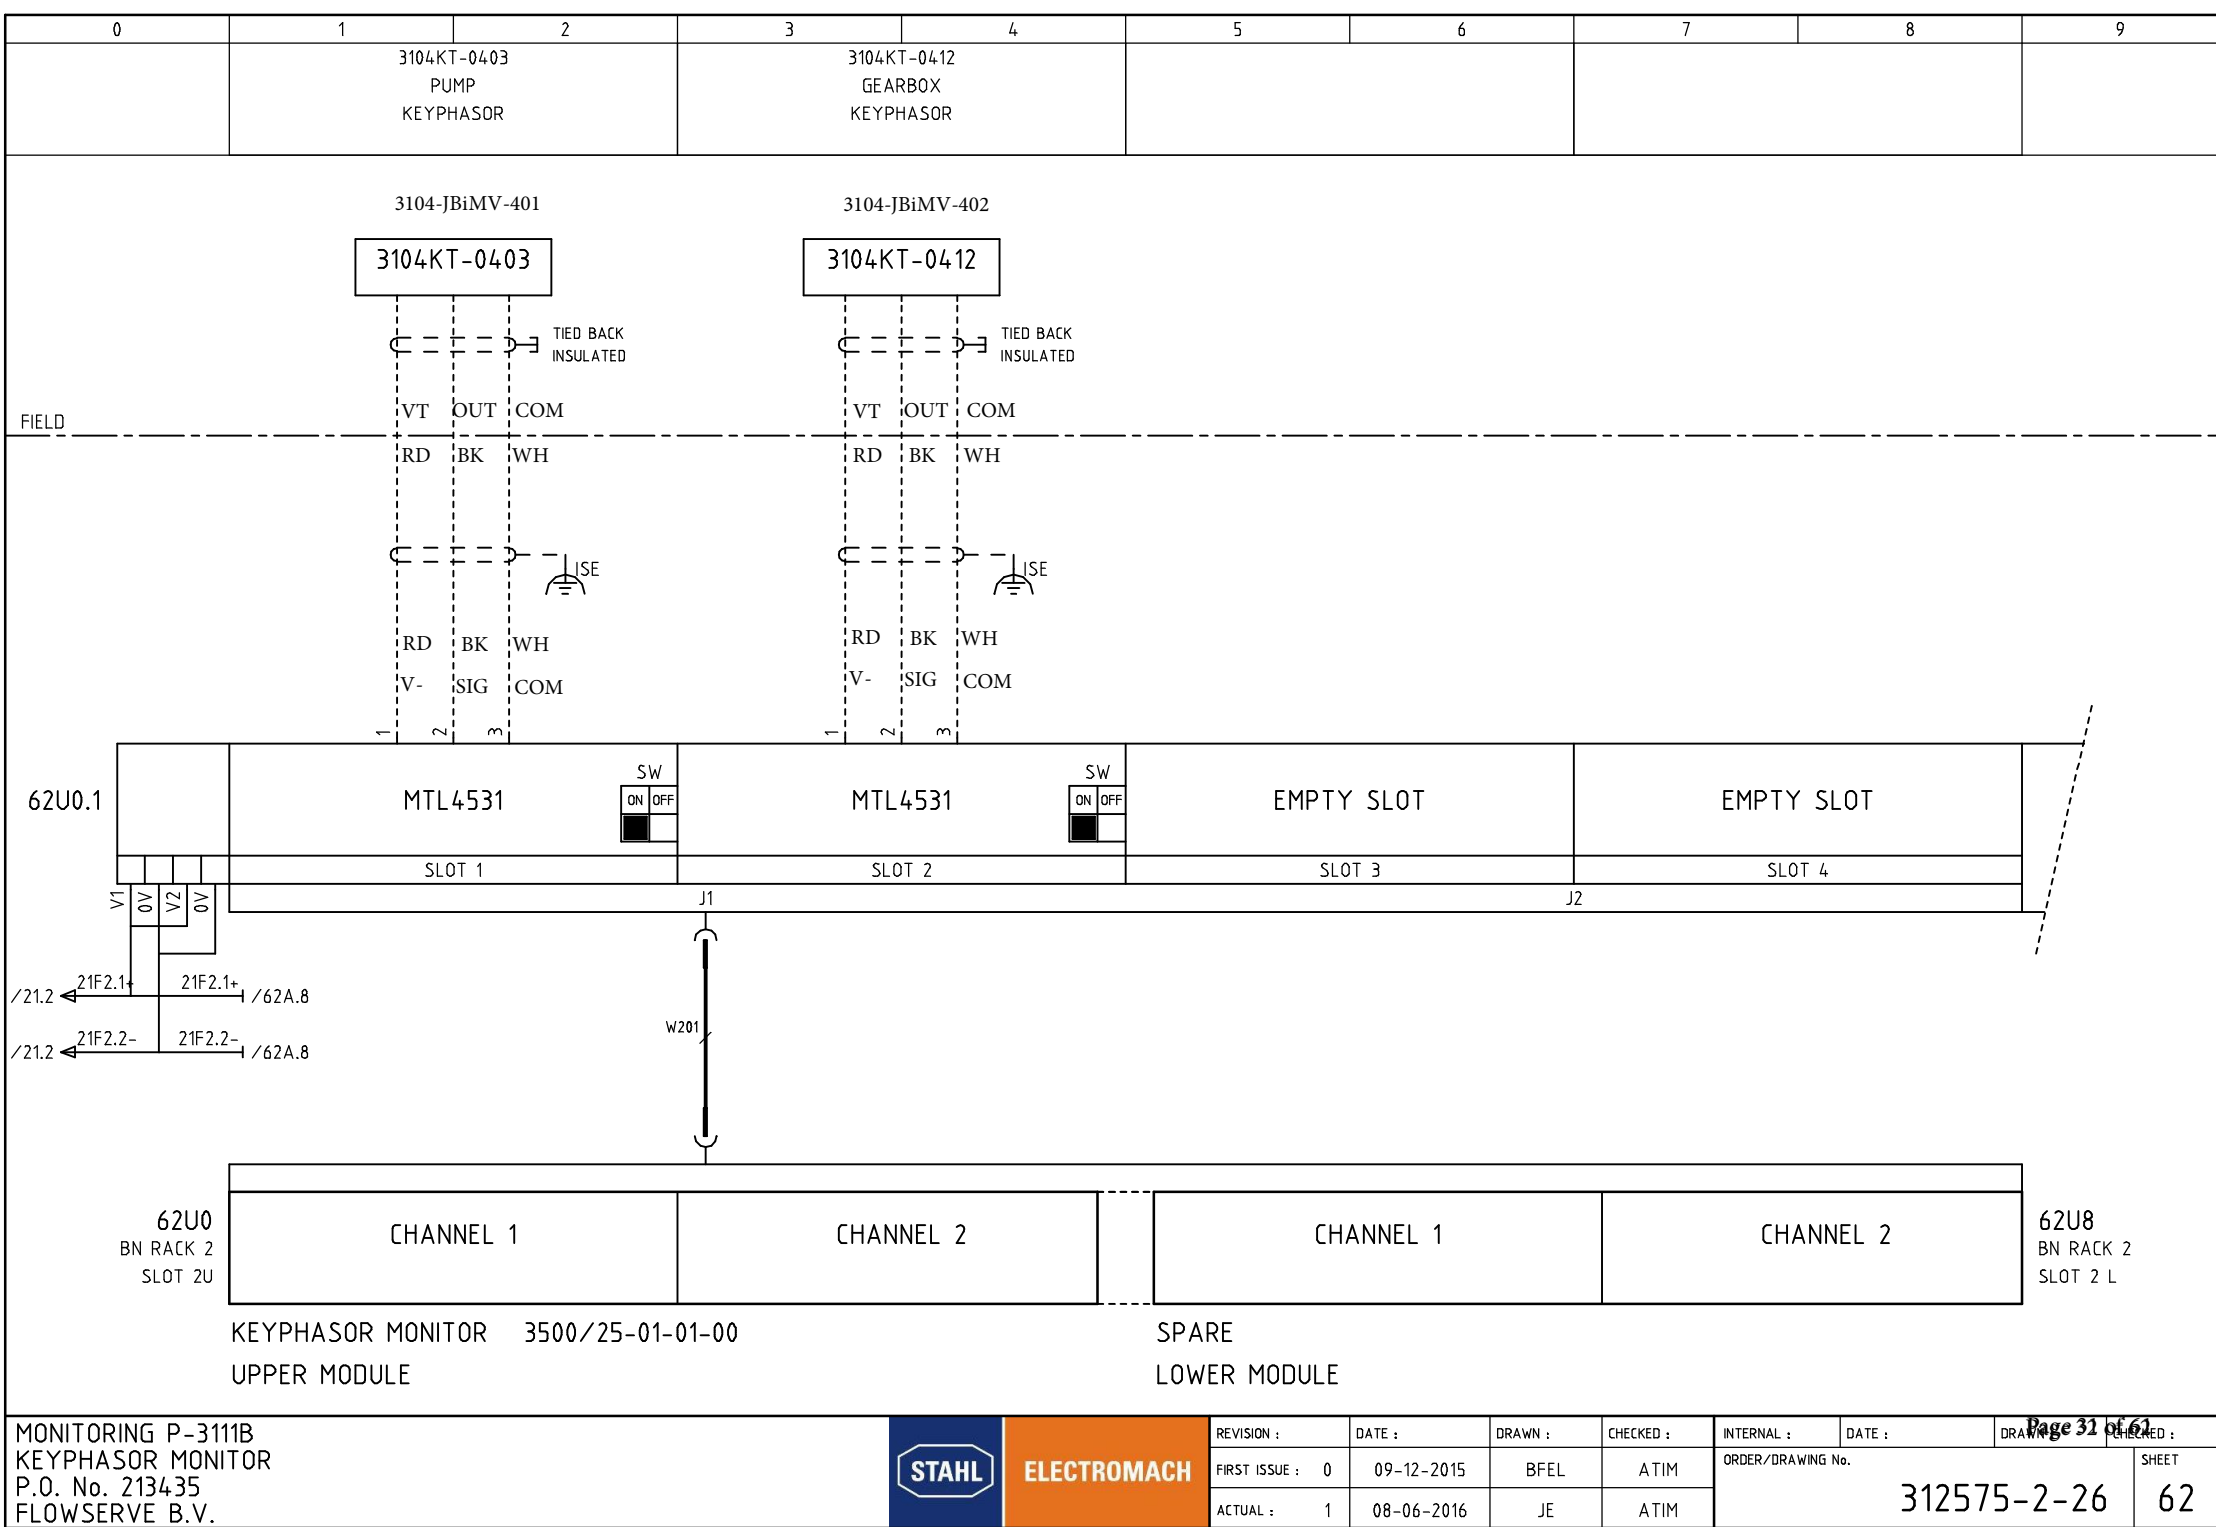

0	1	2	3	4	5	6	7	8	9

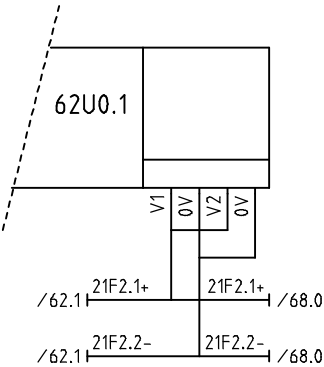

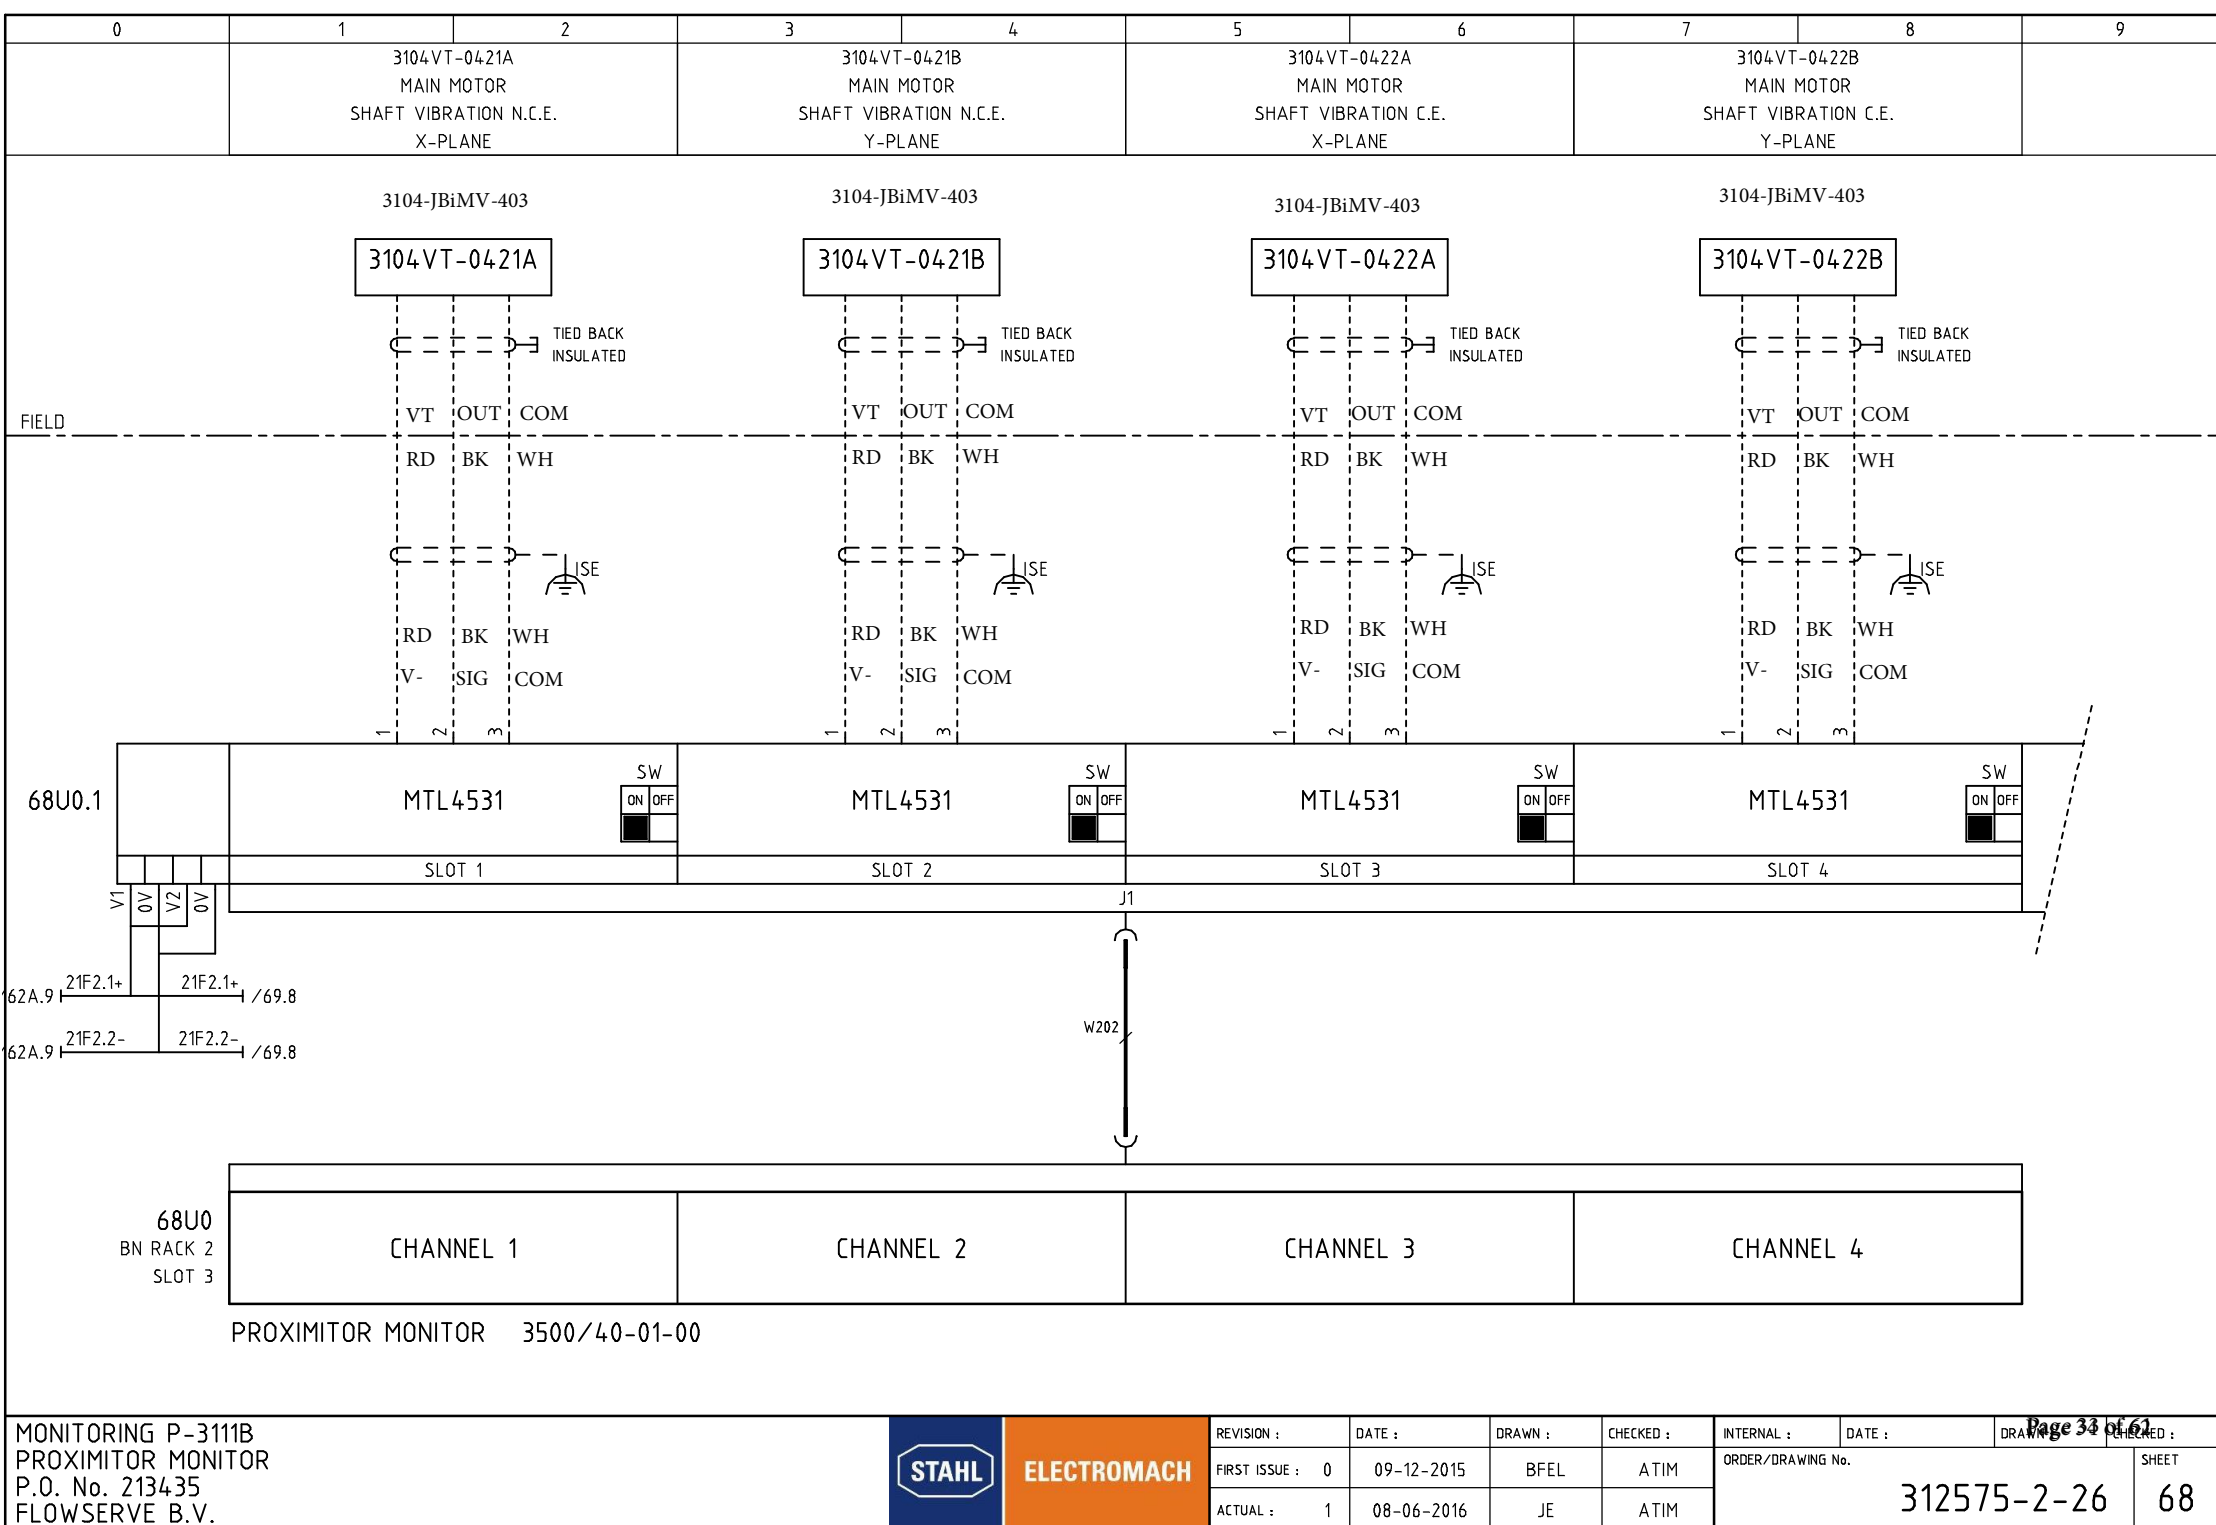

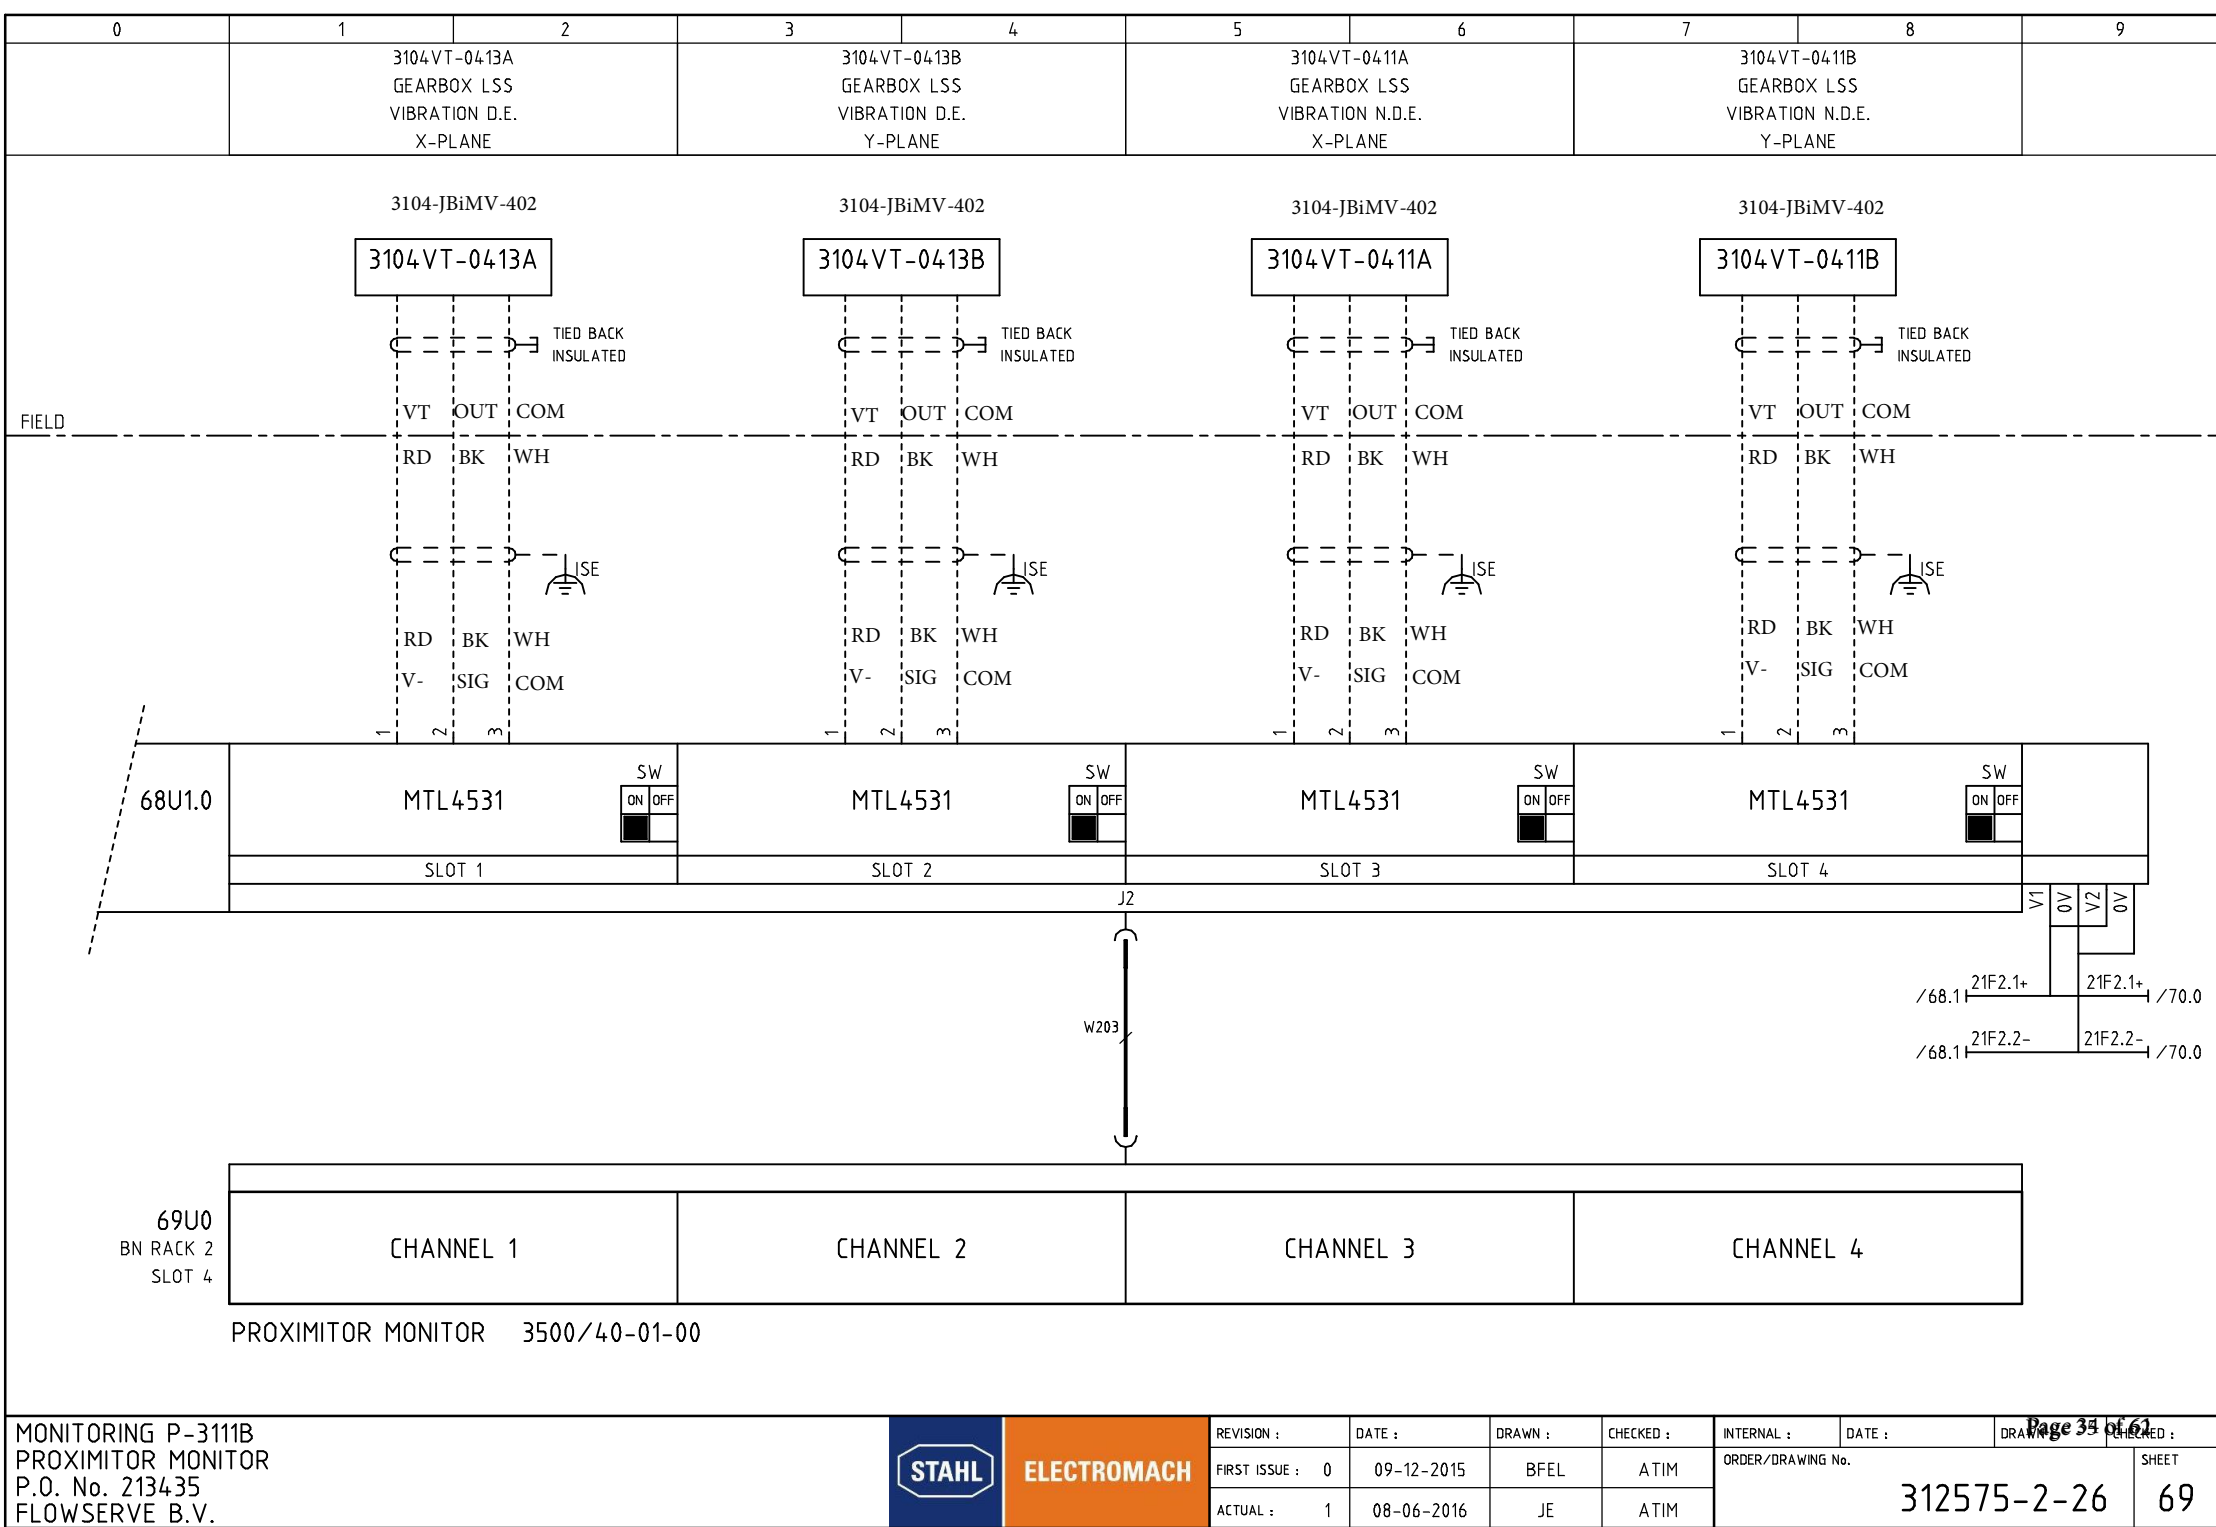

MTL4531

SW

ON

OFF

SLOT 3

MTL4531

SW

ON

OFF

SLOT 4

J2

W203

V1

0V

V2

0V

21F2.1+

21F2.1+

21F2.2-

21F2.2-

/68.1

/70.0

/68.1

/70.0

69U0

BN RACK 2

SLOT 4


CHANNEL 1

CHANNEL 2

CHANNEL 3

CHANNEL 4

PROXIMITOR MONITOR 3500/40-01-00

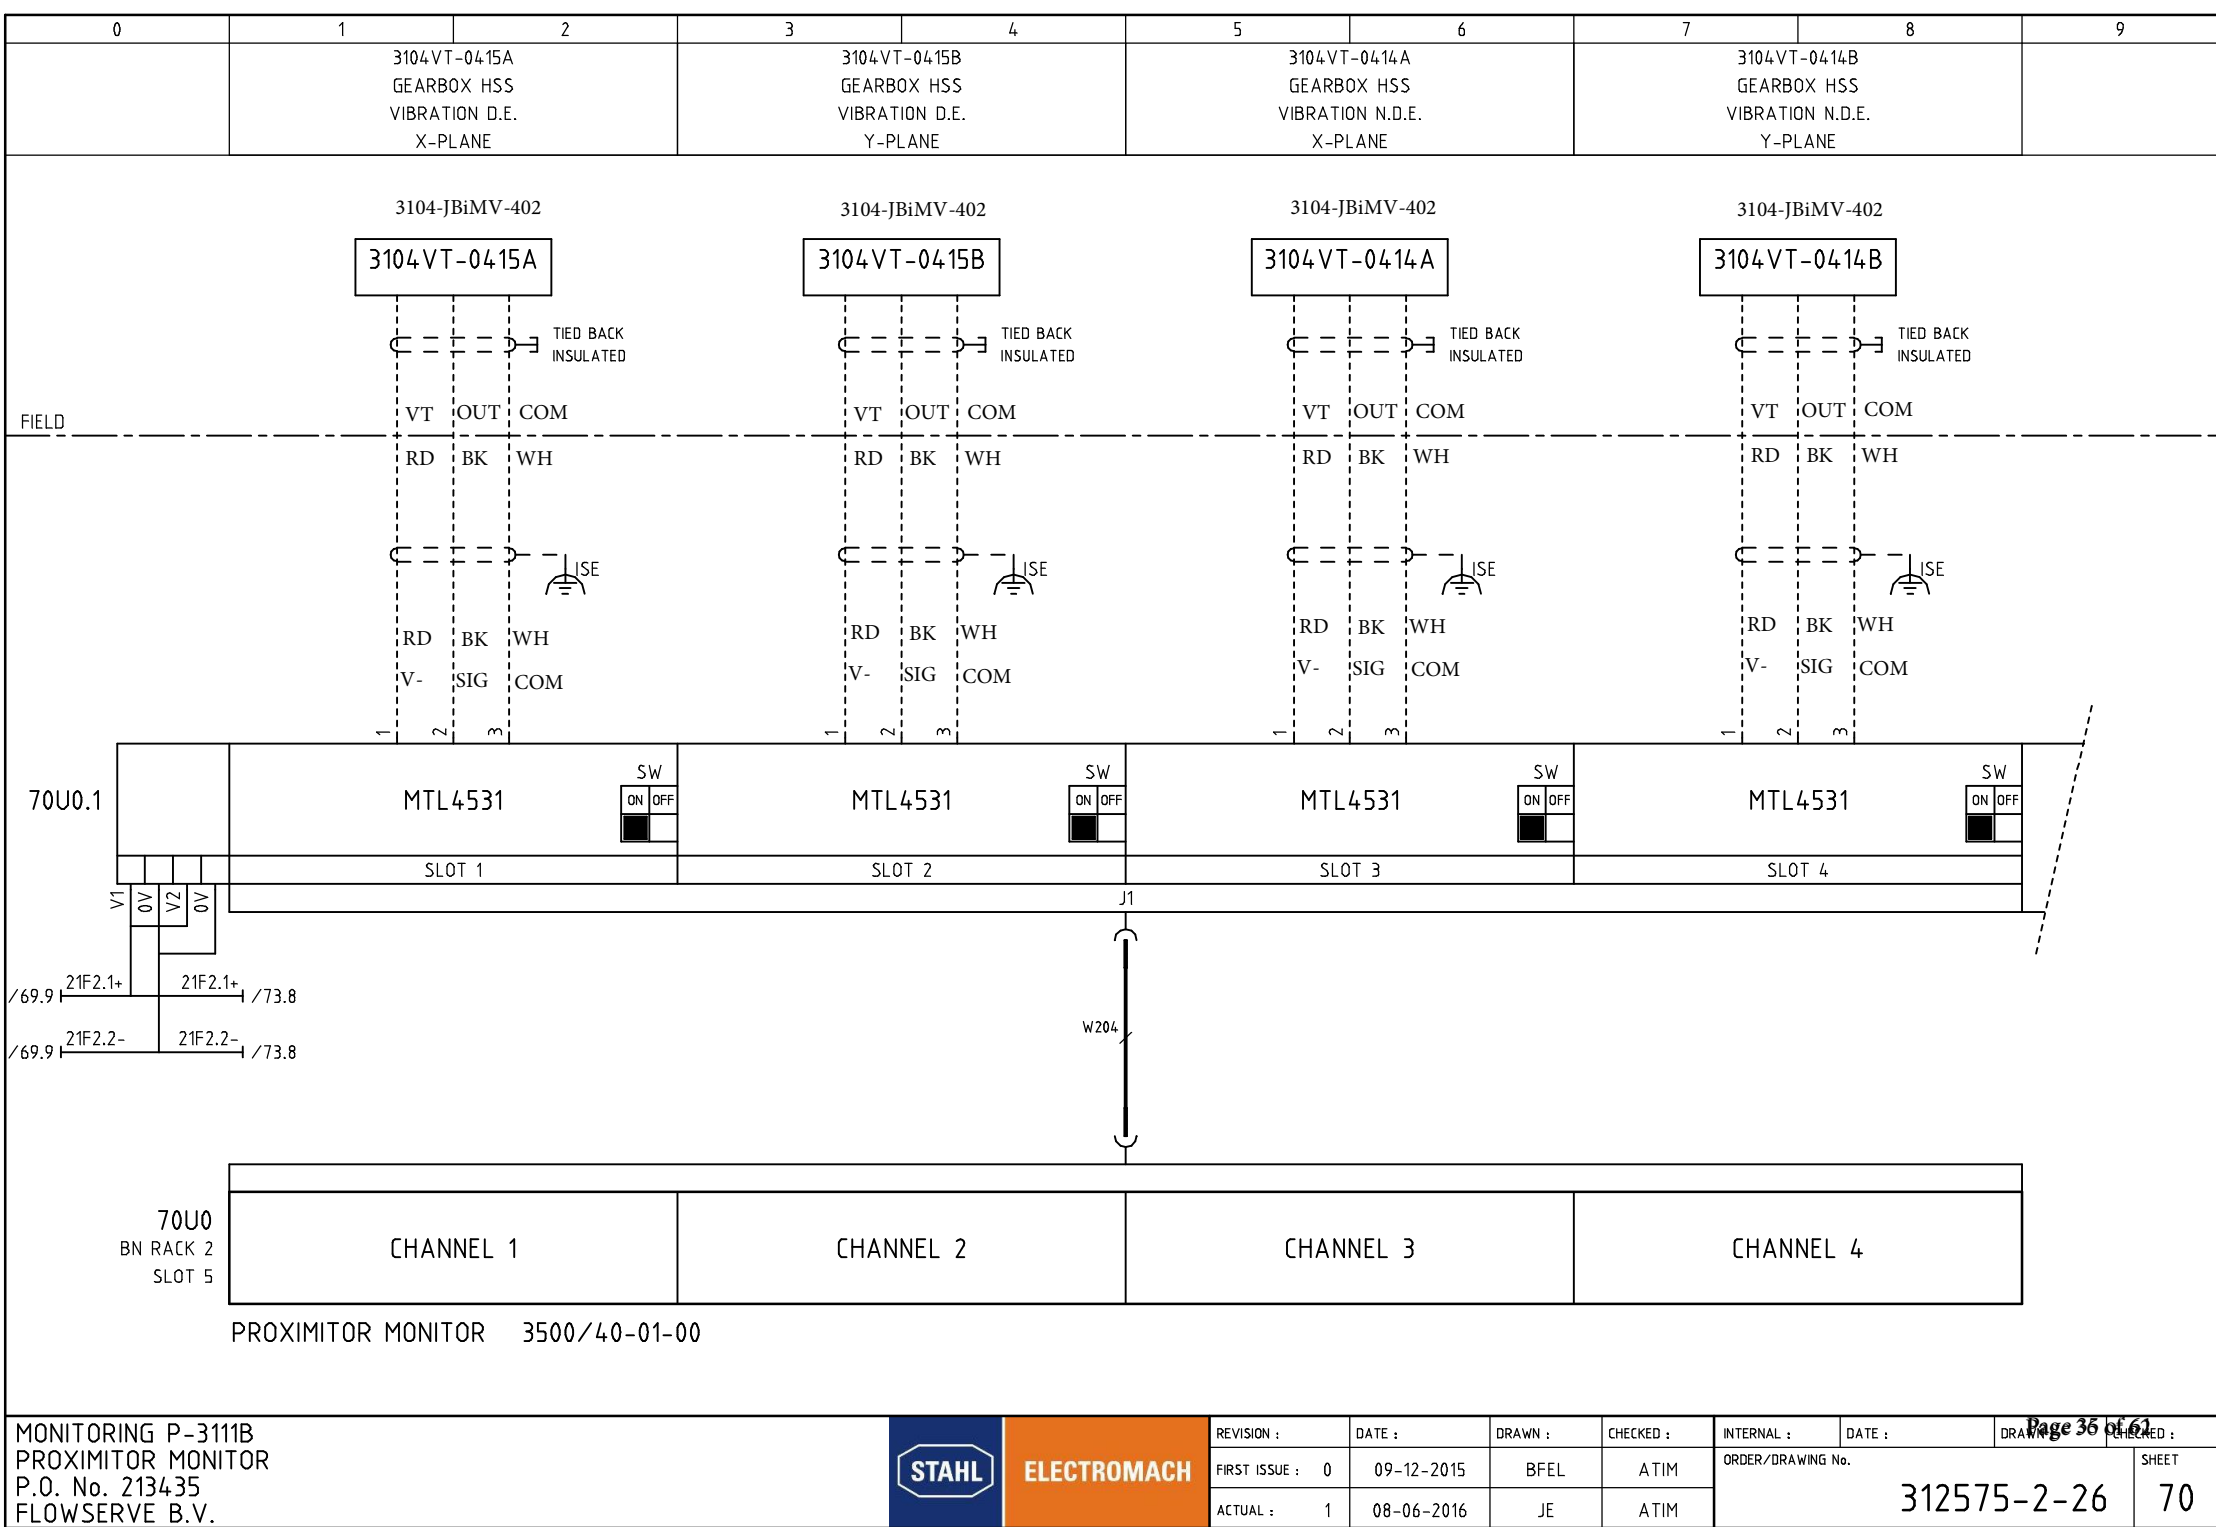

MTL4531

SW

ON

OFF

SLOT 3

MTL4531

SW

ON

OFF

SLOT 4

V1

OV

V2

OV

21F2.1+

21F2.1+

73.8

21F2.2-

21F2.2-

73.8

J1

W204

MONITORING P-3111B

PROXIMITOR MONITOR


P.O. No. 213435

FLOWERVE B.V.

STAHL

ELECTROMACH

Page 36 of 61

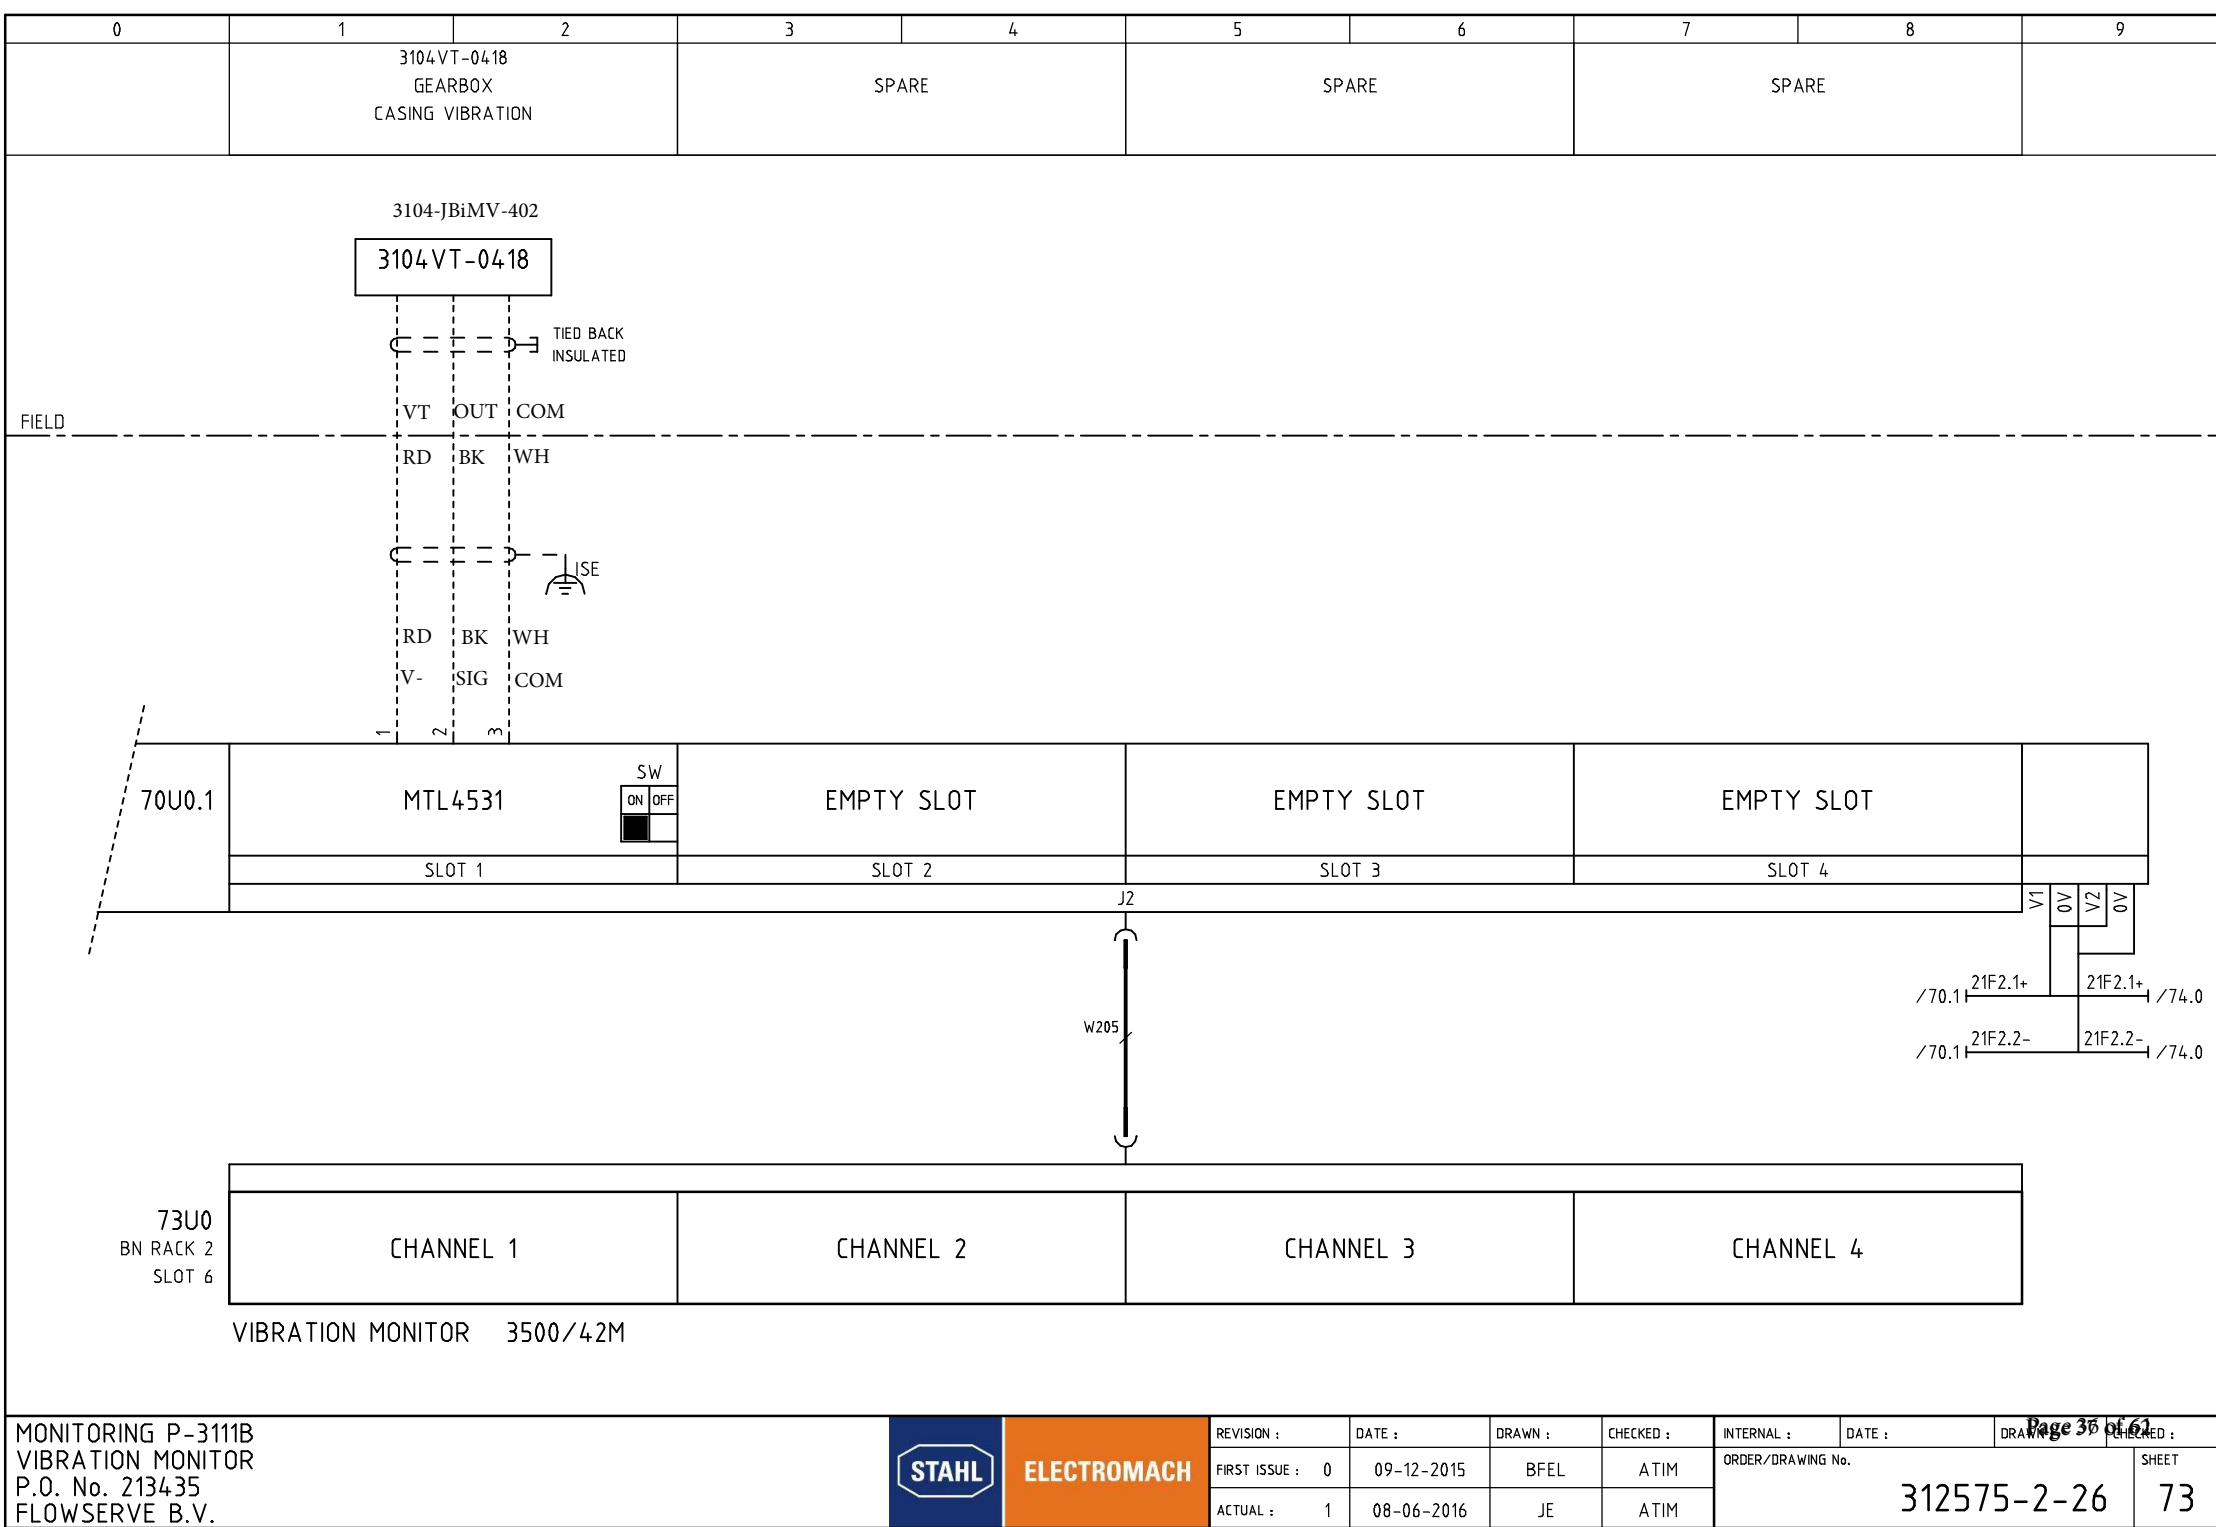

MONITORING P-3111B

VIBRATION MONITOR


P.O. No. 213435

FLOWERVE B.V.

STAHL

ELECTROMACH

Page 36 of 61

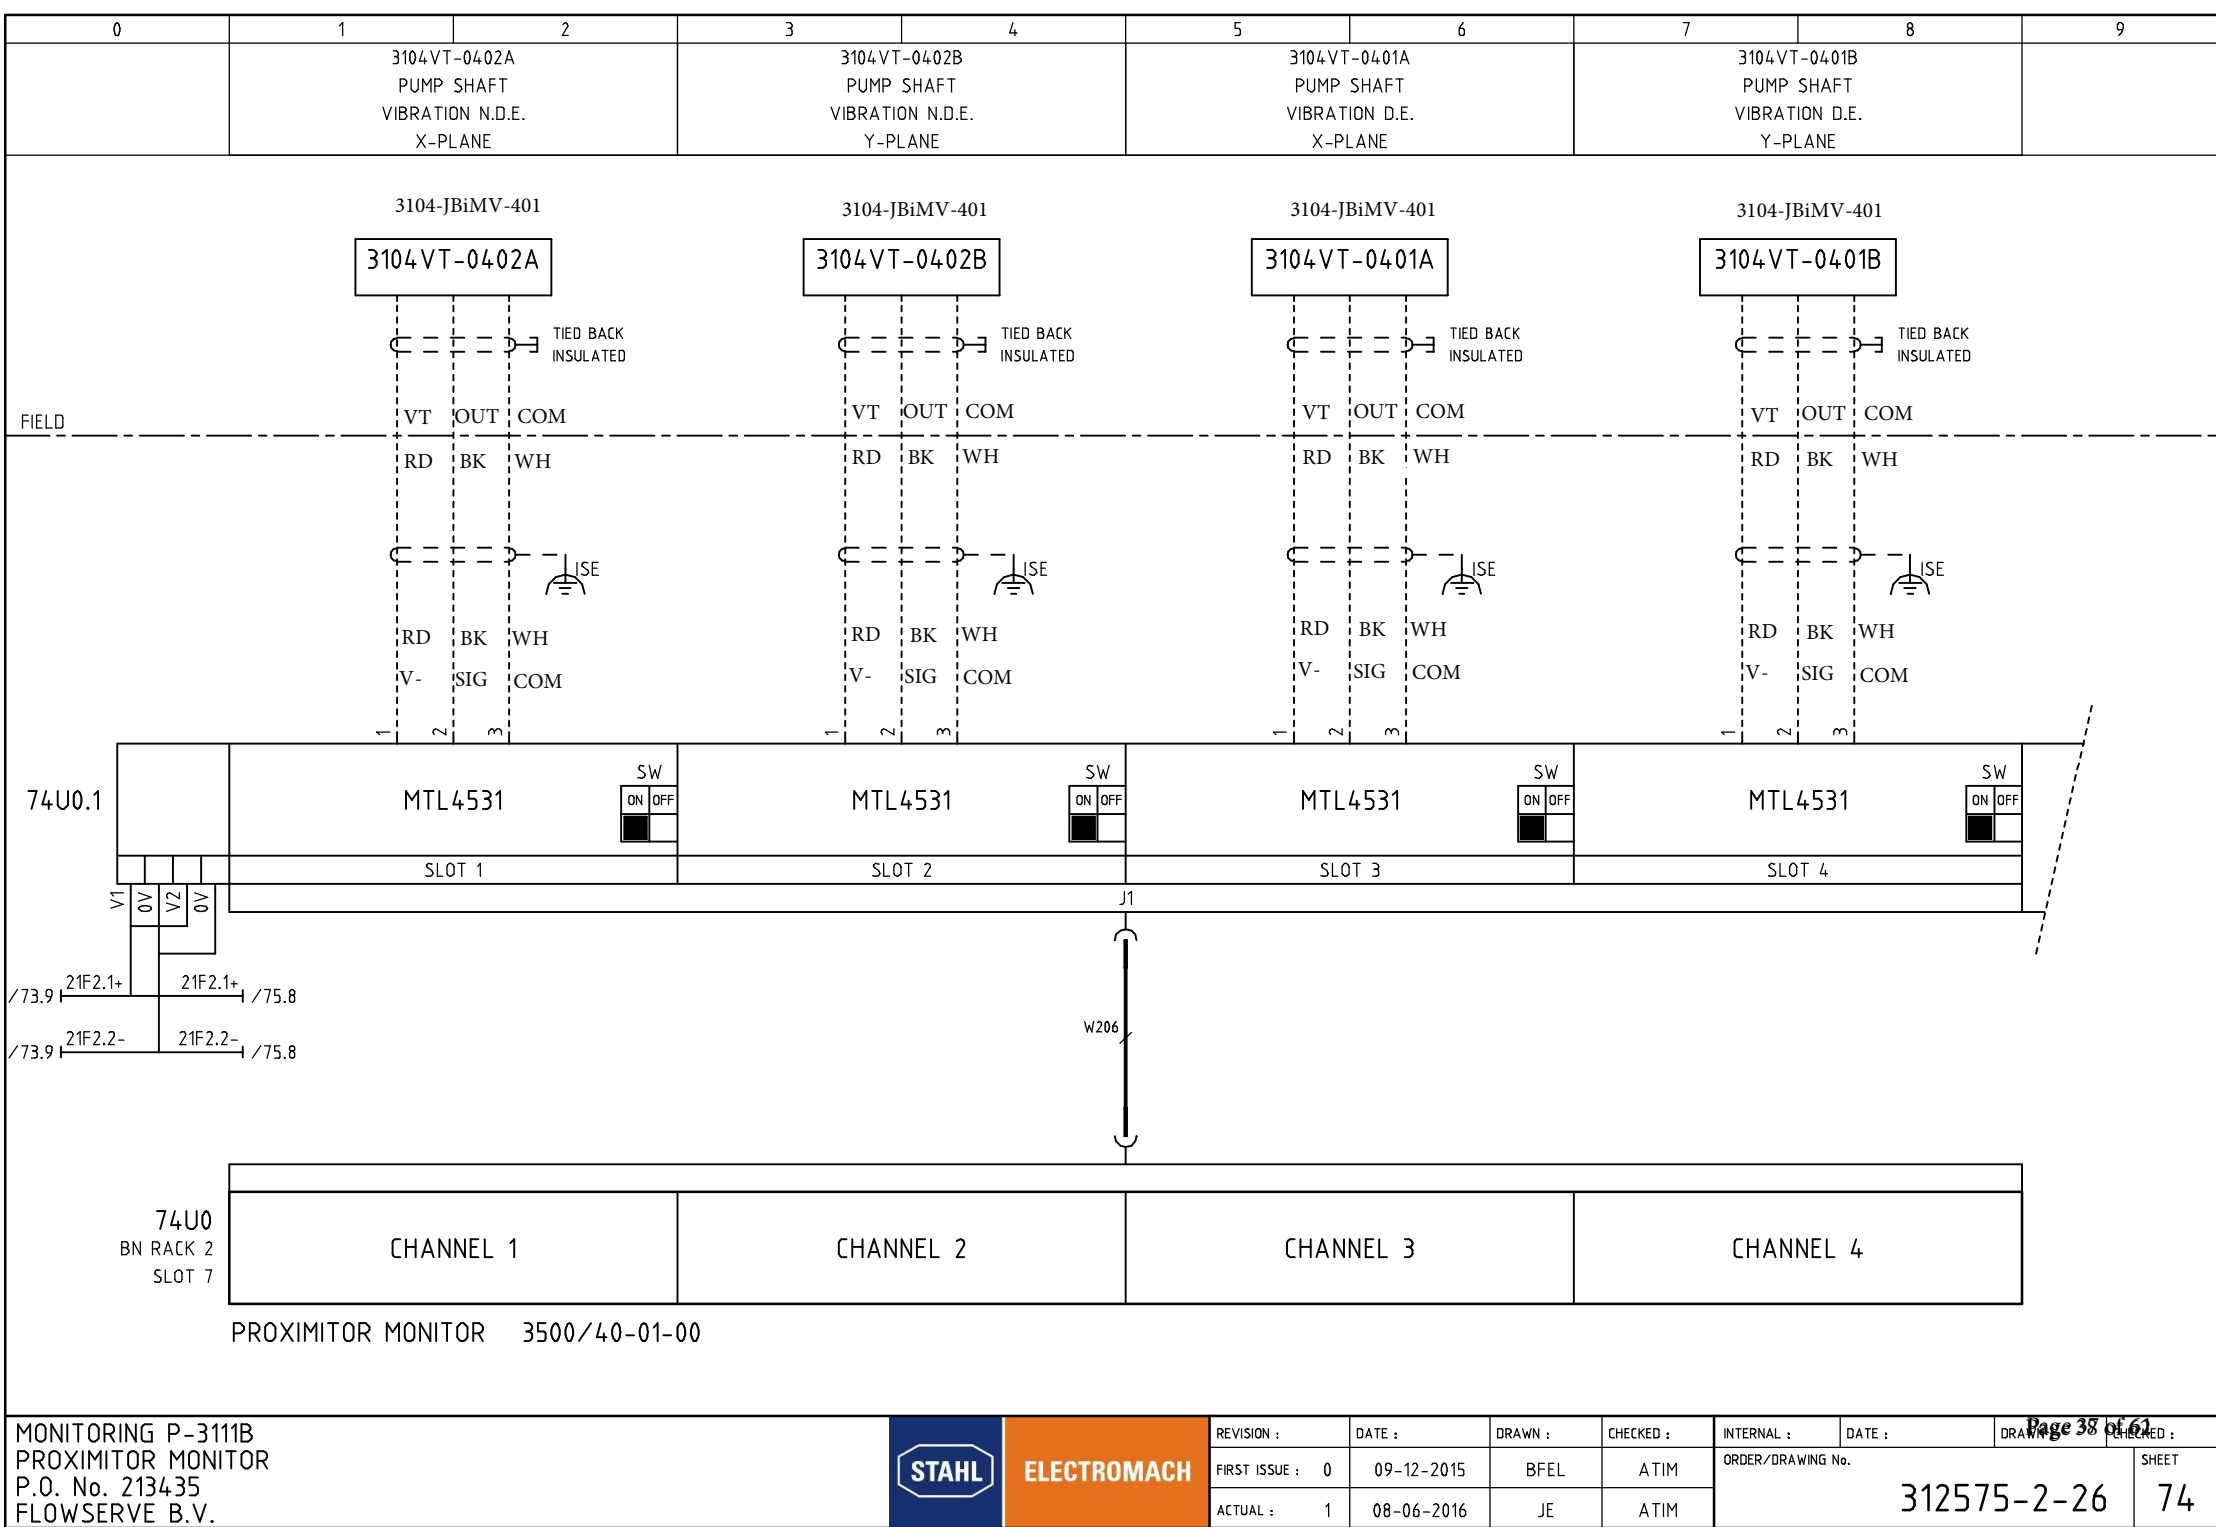

MTL4531

SW

ON

OFF

SLOT 3

MTL4531

SW

ON

OFF

SLOT 4

V1

OV

V2

OV

21F2.1+

21F2.1+

73.9

75.8

21F2.2-

21F2.2-

73.9

75.8

J1

W206

MONITORING P-3111B

PROXIMITOR MONITOR


P.O. No. 213435


FLOWERVE B.V.

STAHL


ELECTROMACH


Page 38 of 61

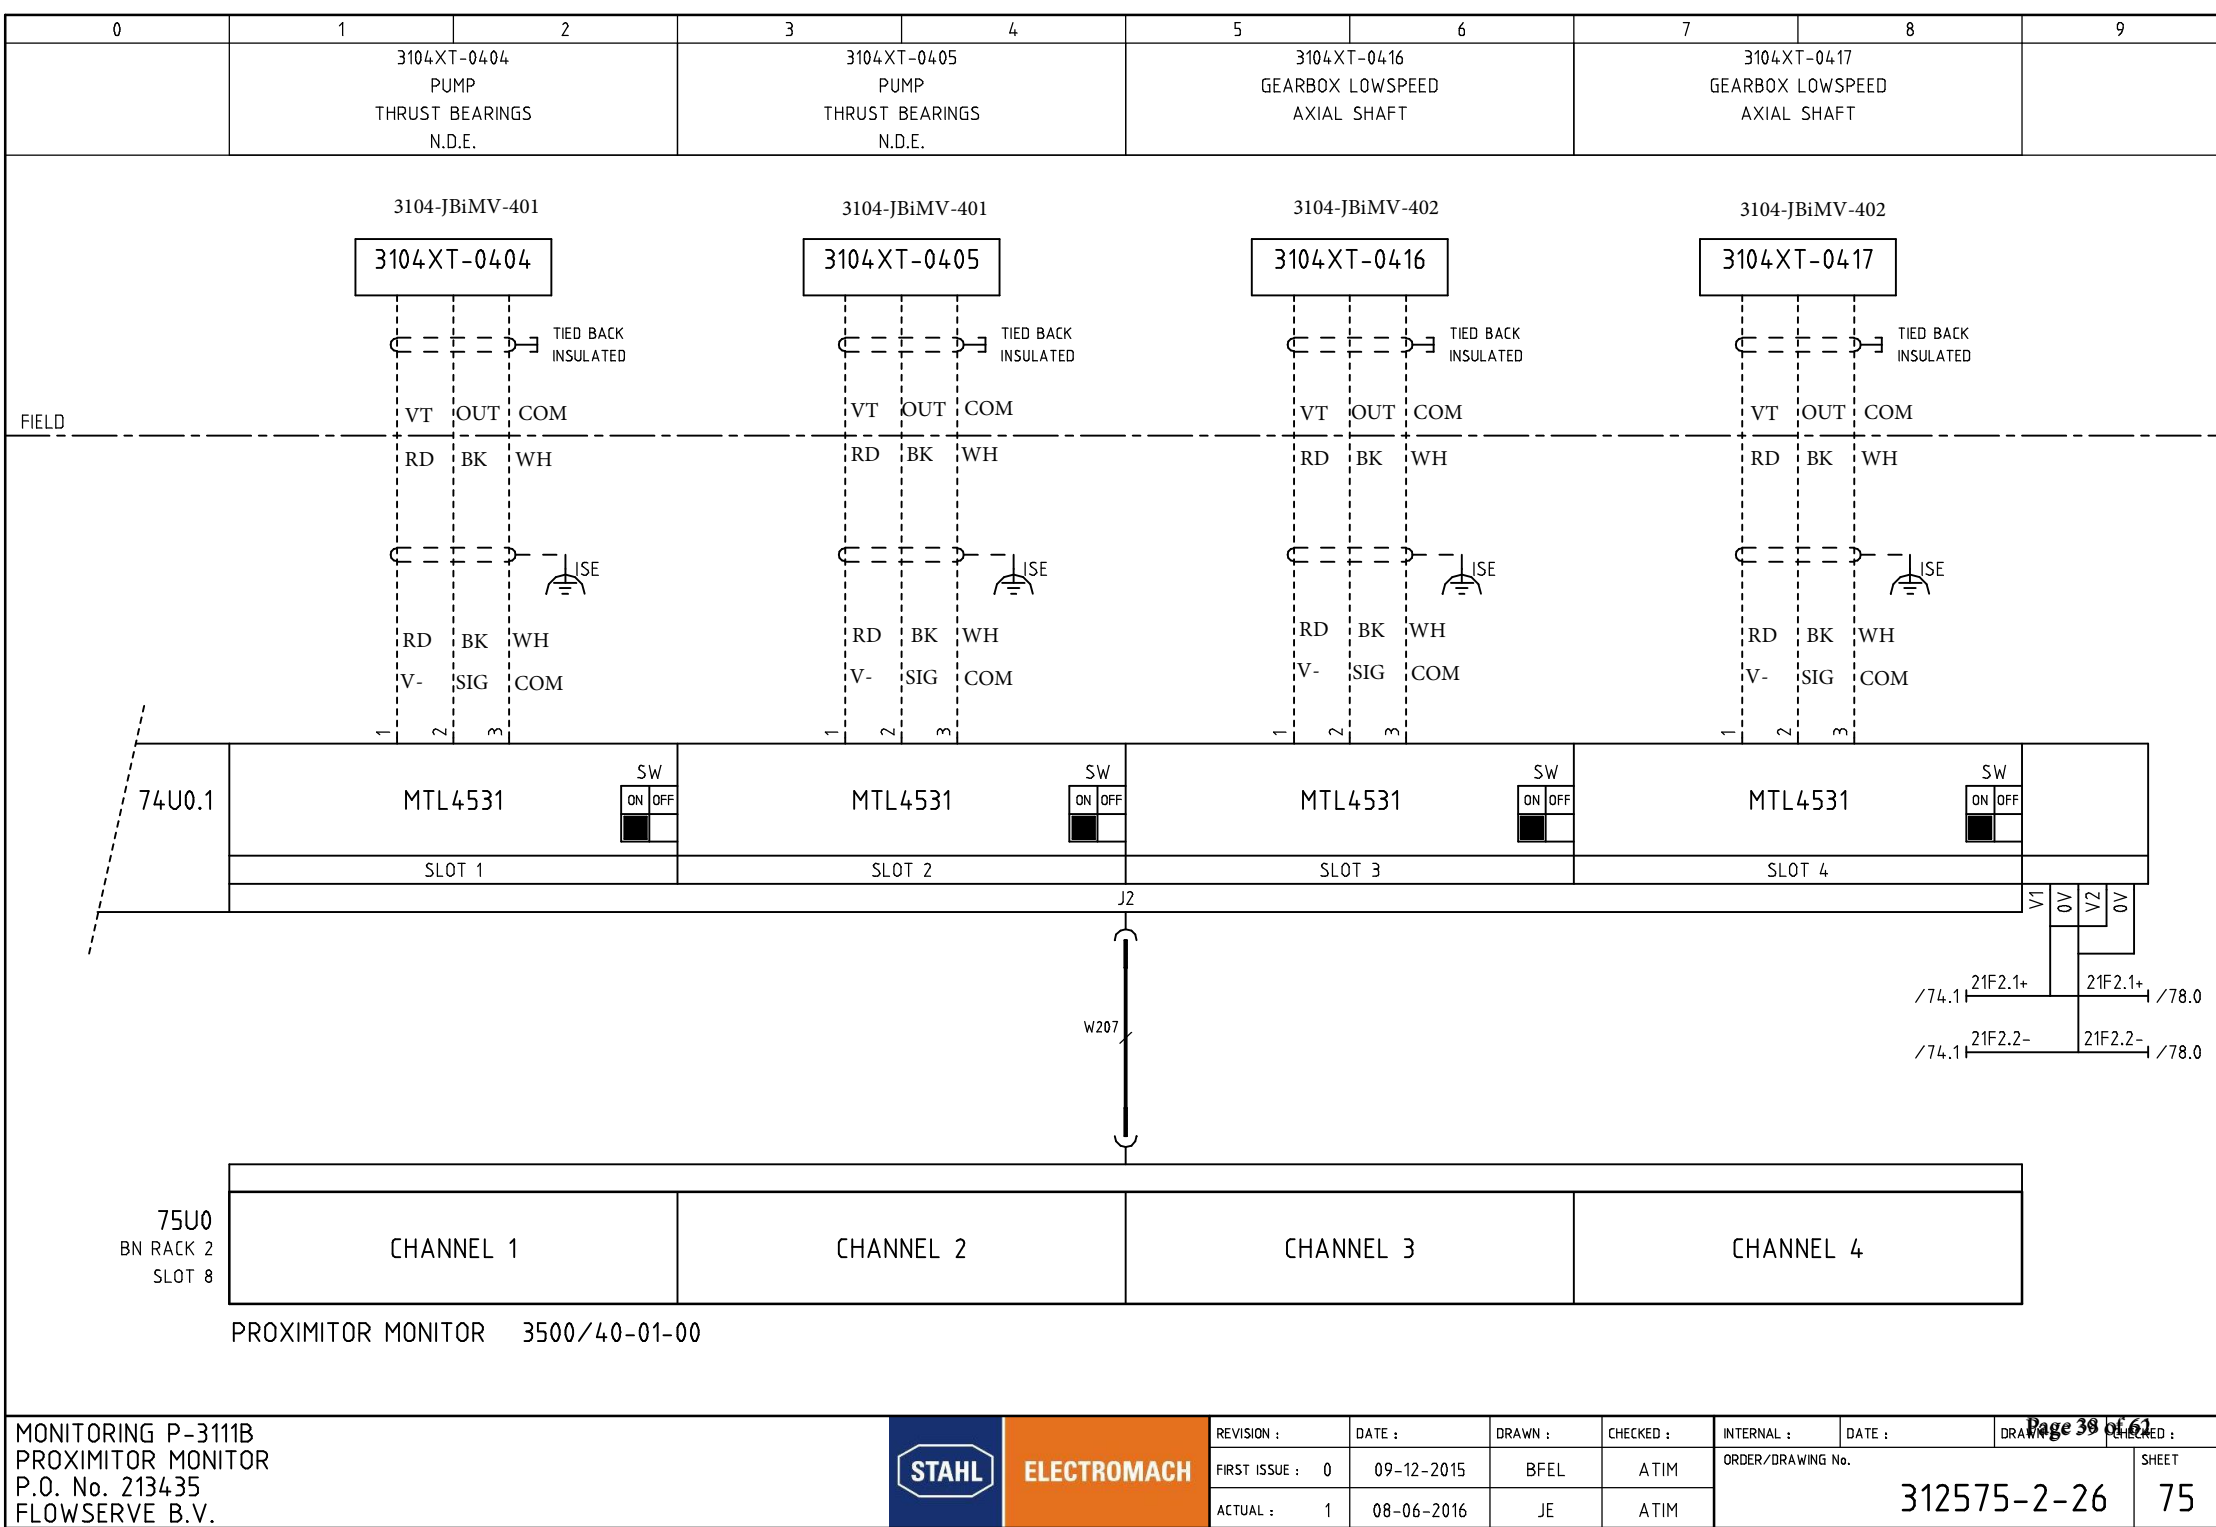

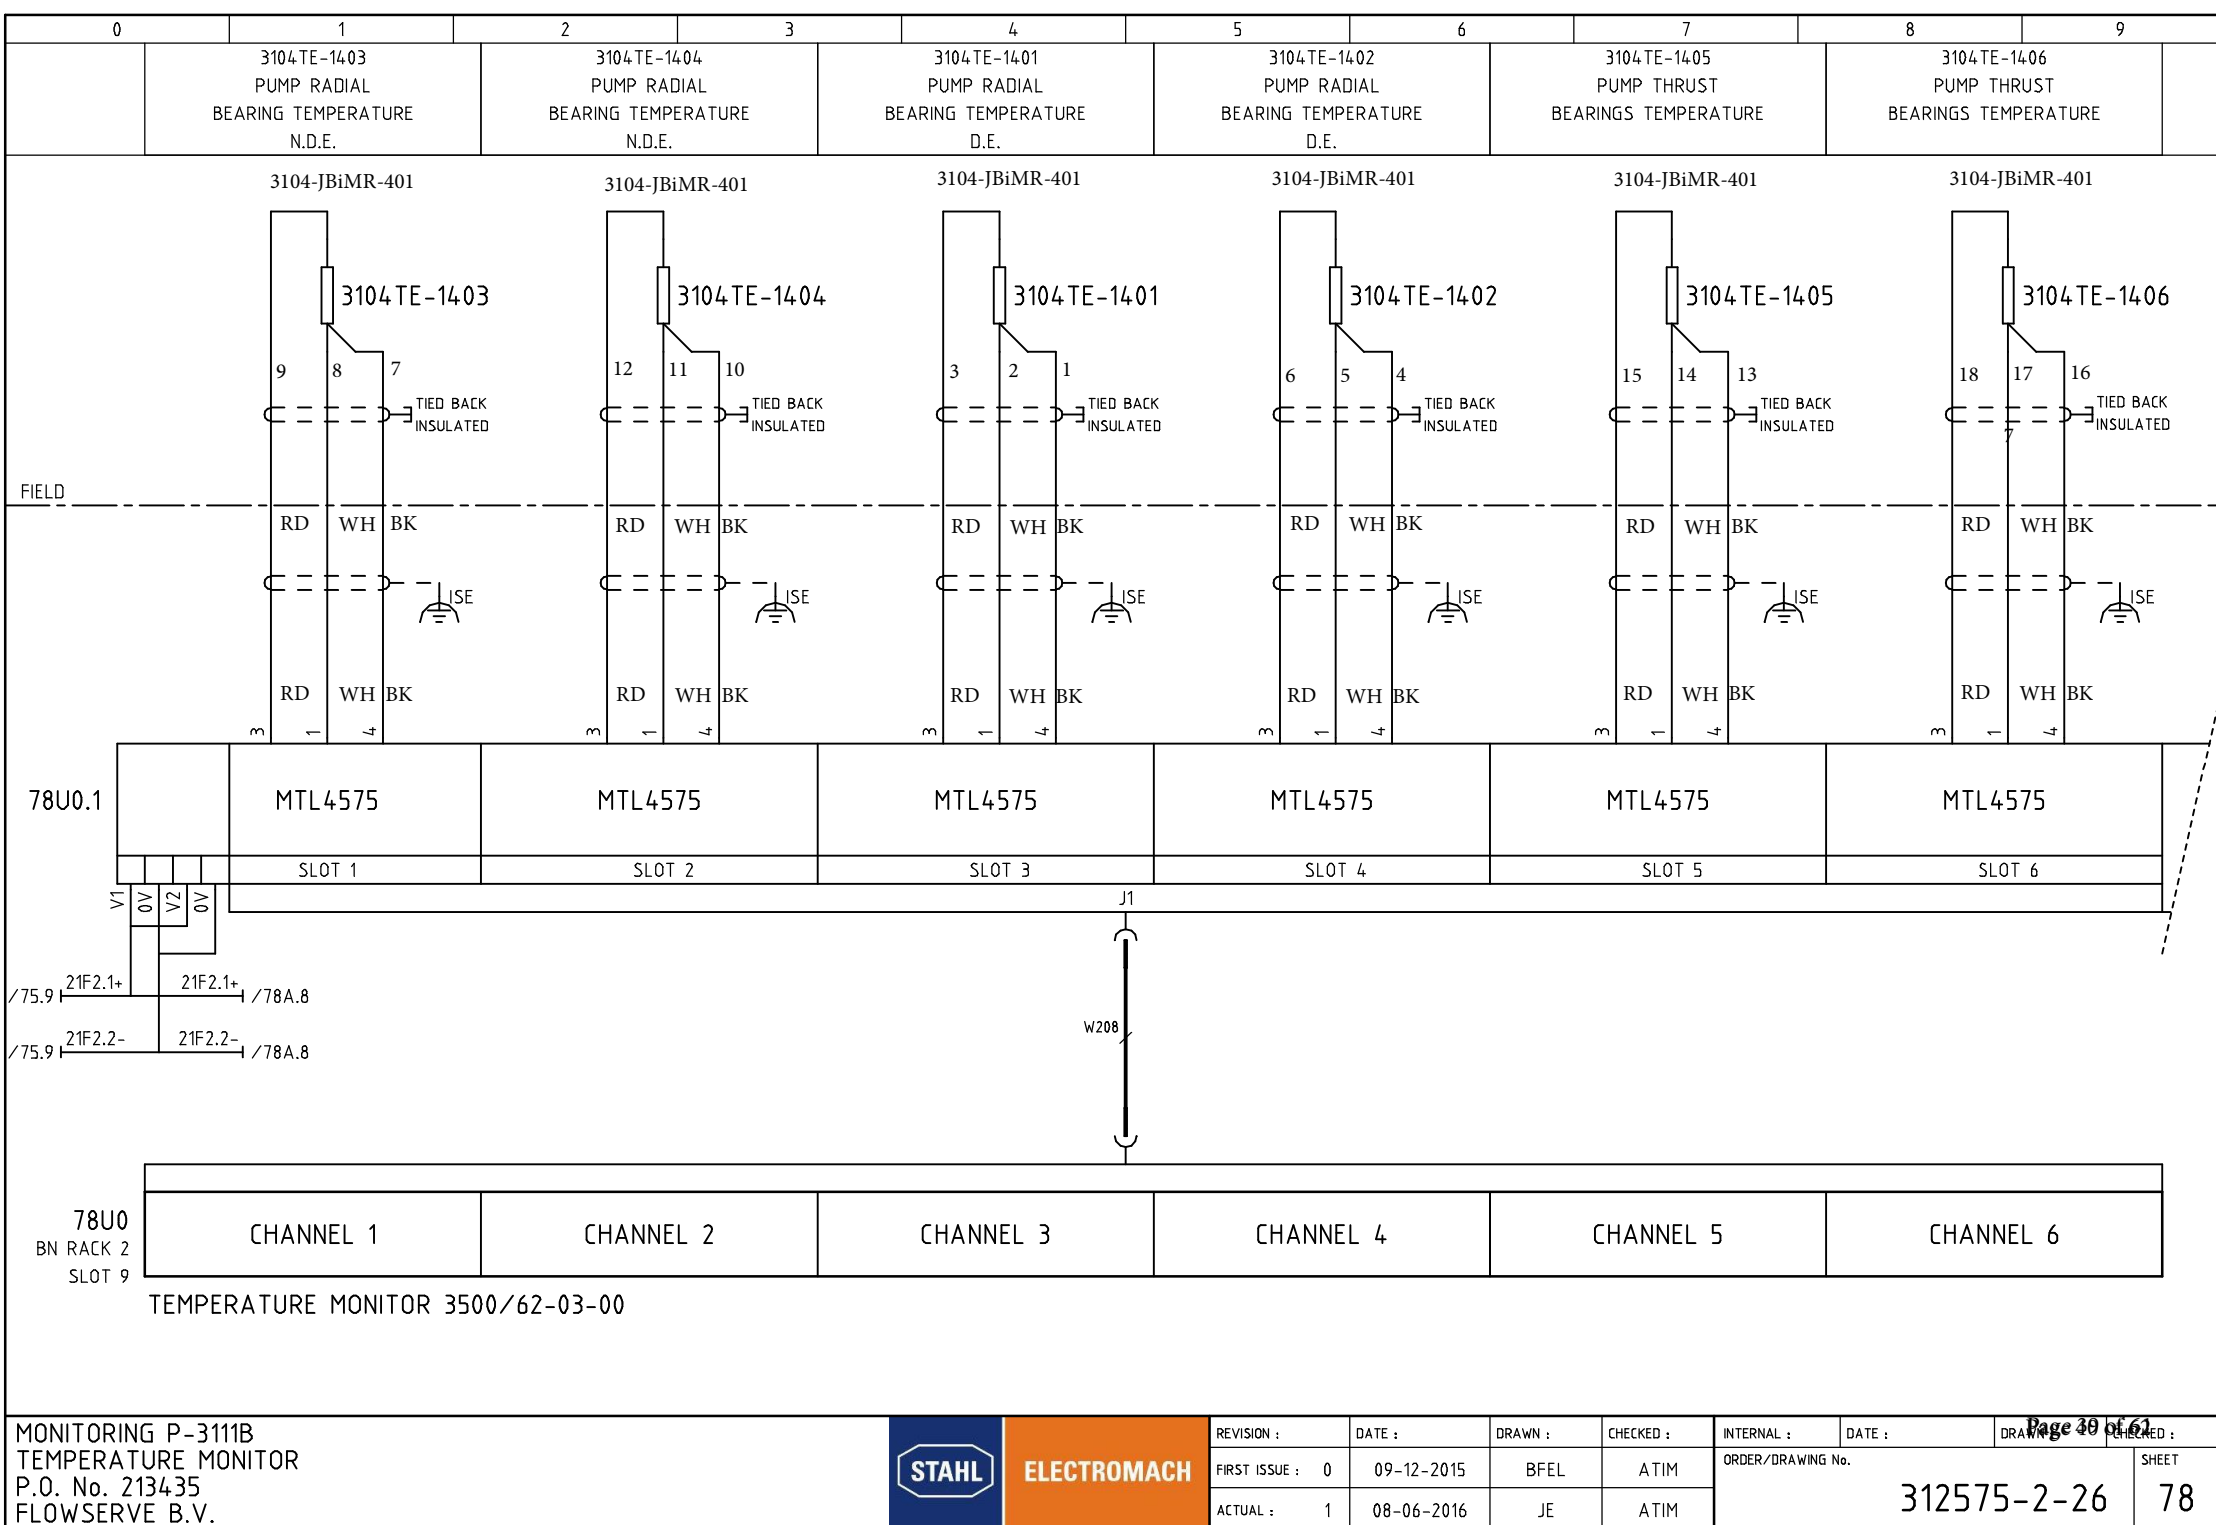



0	1	2	3	4	5	6	7	8	9

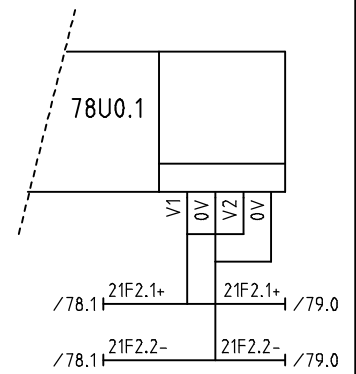

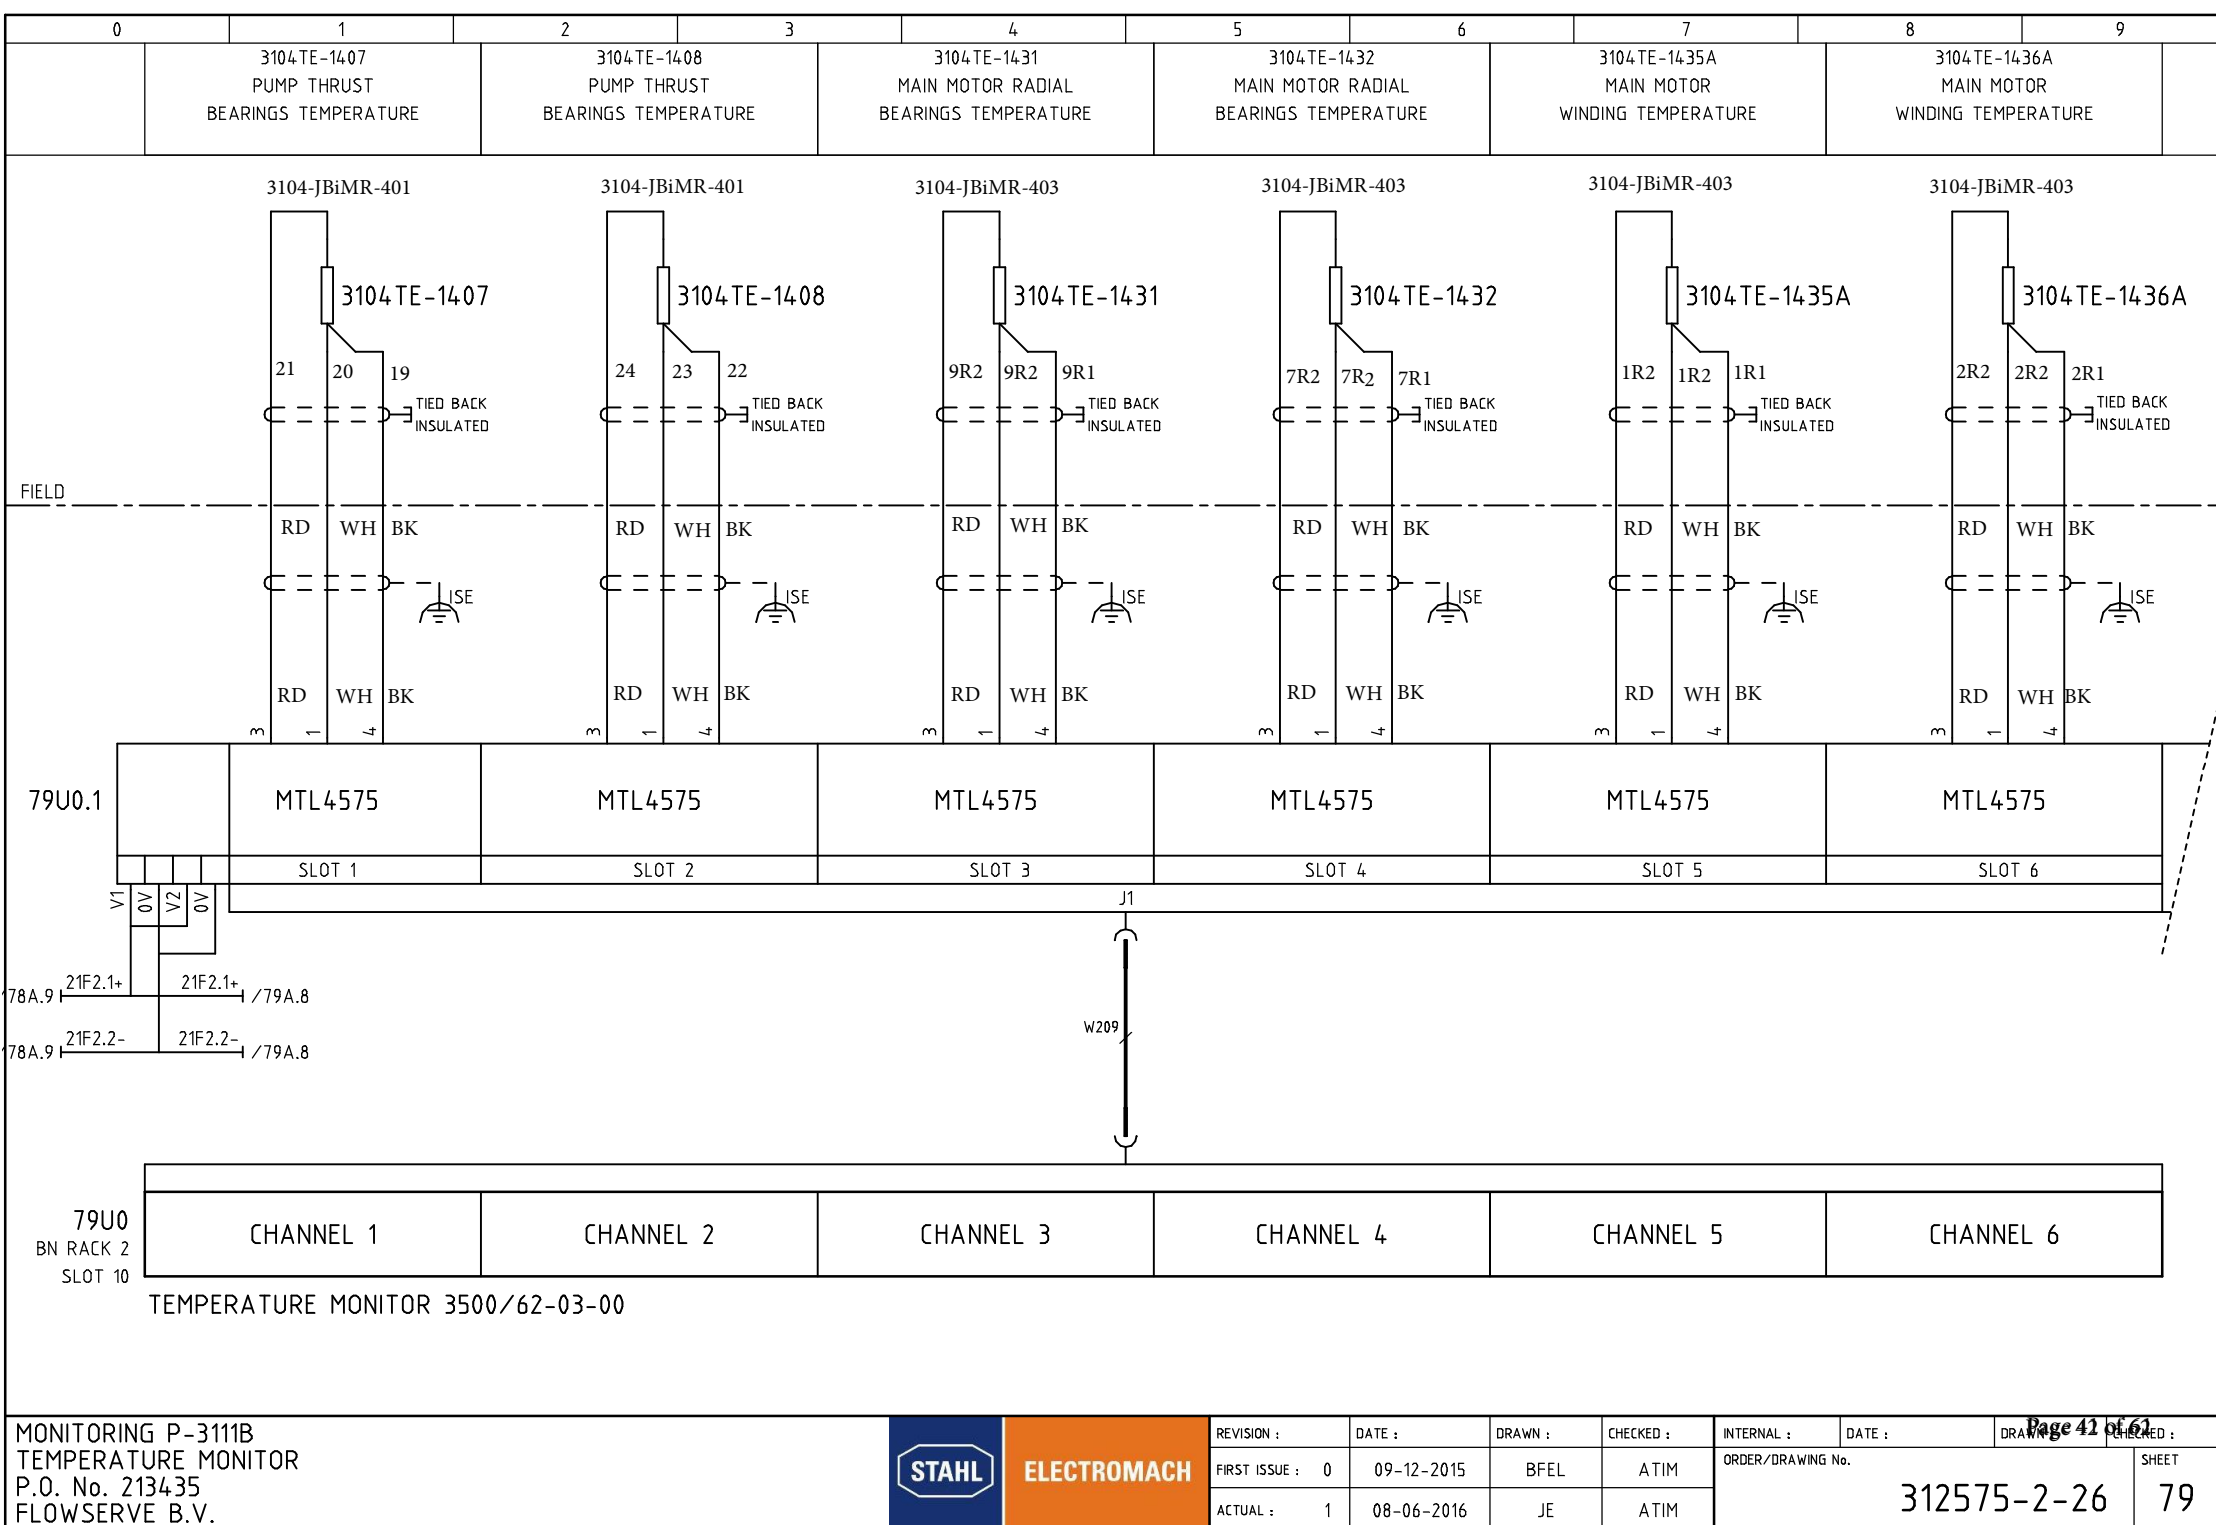

0	1	2	3	4	5	6	7	8	9

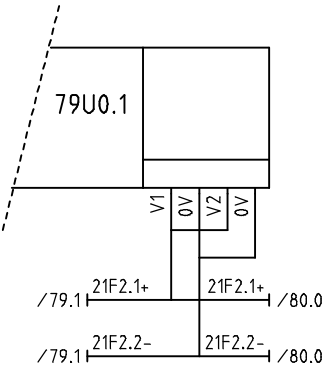

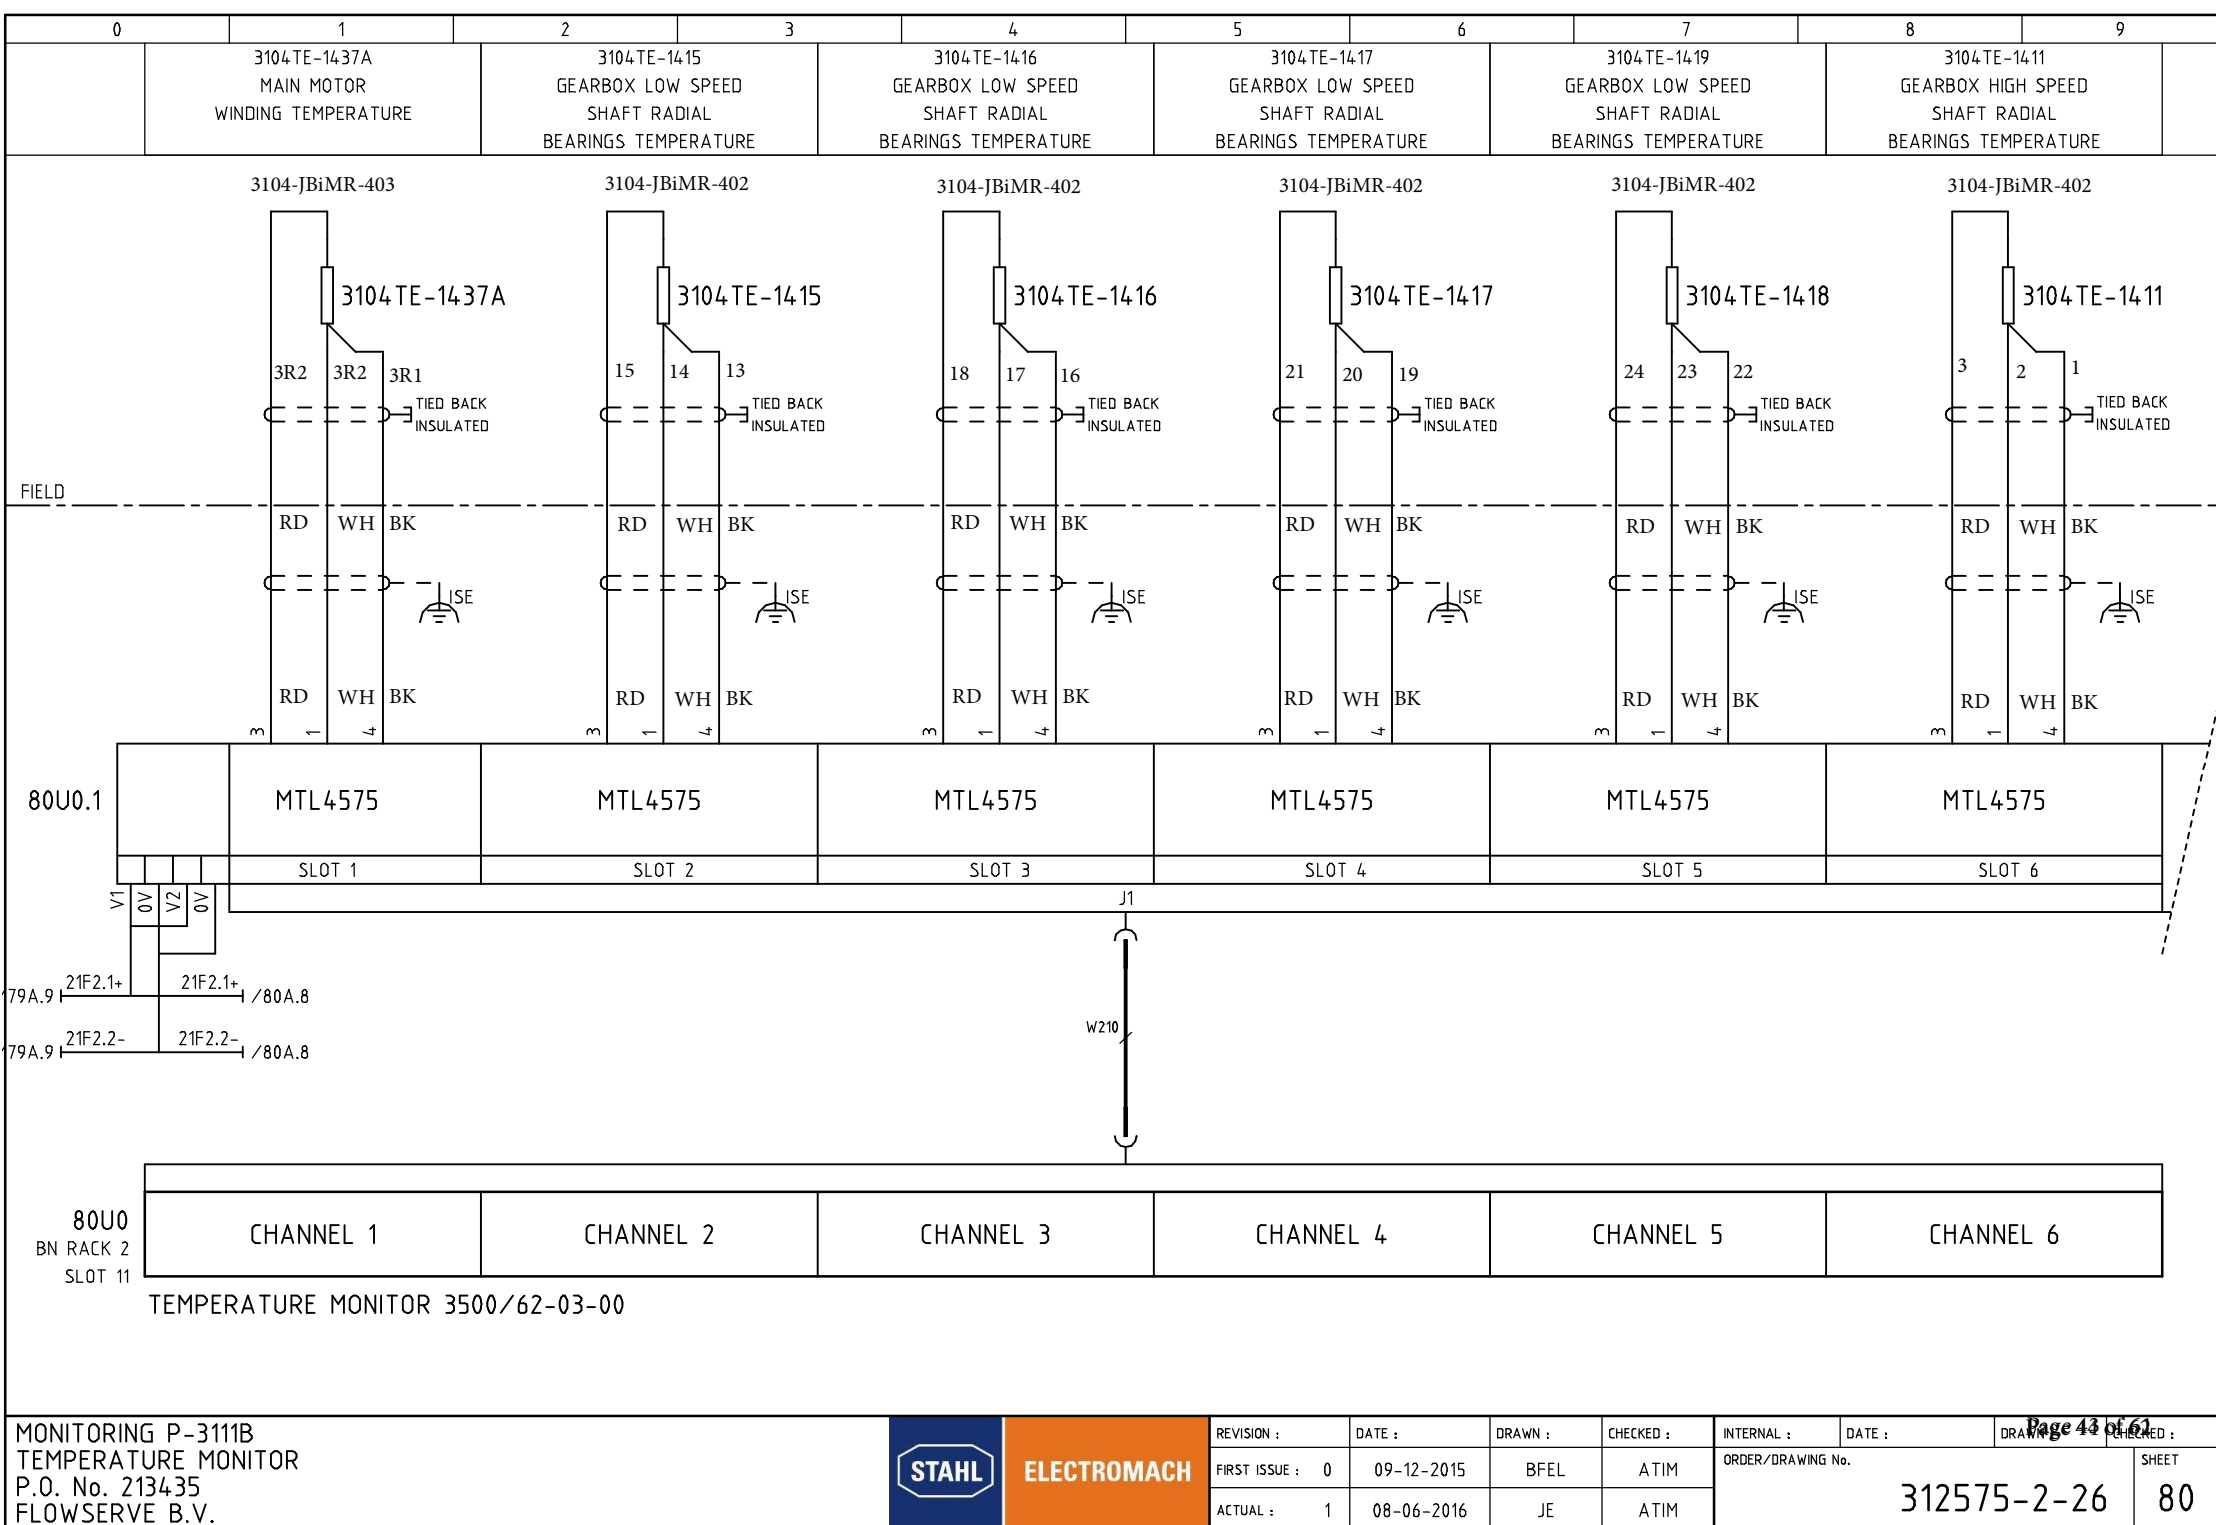

80U0.1

MTL4575

MTL4575

SLOT 1

SLOT 2

SLOT 3

SLOT 4

SLOT 5

SLOT 6

V1 0V V2 0V

21F2.1+ 21F2.1+ /80A.8

21F2.2- 21F2.2- /80A.8

J1

W210

80U0

BN RACK 2

SLOT 11

CHANNEL 1

CHANNEL 2

CHANNEL 3

CHANNEL 4

CHANNEL 5

CHANNEL 6

TEMPERATURE MONITOR 3500/62-03-00

MONITORING P-3111B

TEMPERATURE MONITOR

P.O. No. 213435

FLOWERVE B.V.

STAHL

ELECTROMACH

REVISION :

DATE :

DRAWN :

CHECKED :

INTERNAL :

DATE :

DRAWN :

CHECKED :

FIRST ISSUE :

0

09-12-2015

BFEL

ATIM

ORDER/DRAWING No.

312575-2-26

SHEET

80

ACTUAL :

1


08-06-2016


JE

ATIM


Page 44 of 61


0	1	2	3	4	5	6	7	8	9

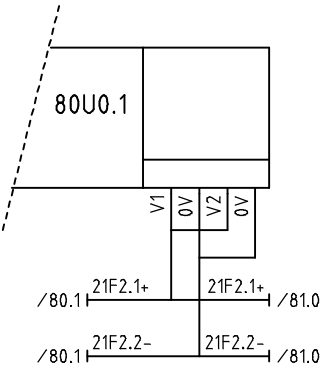

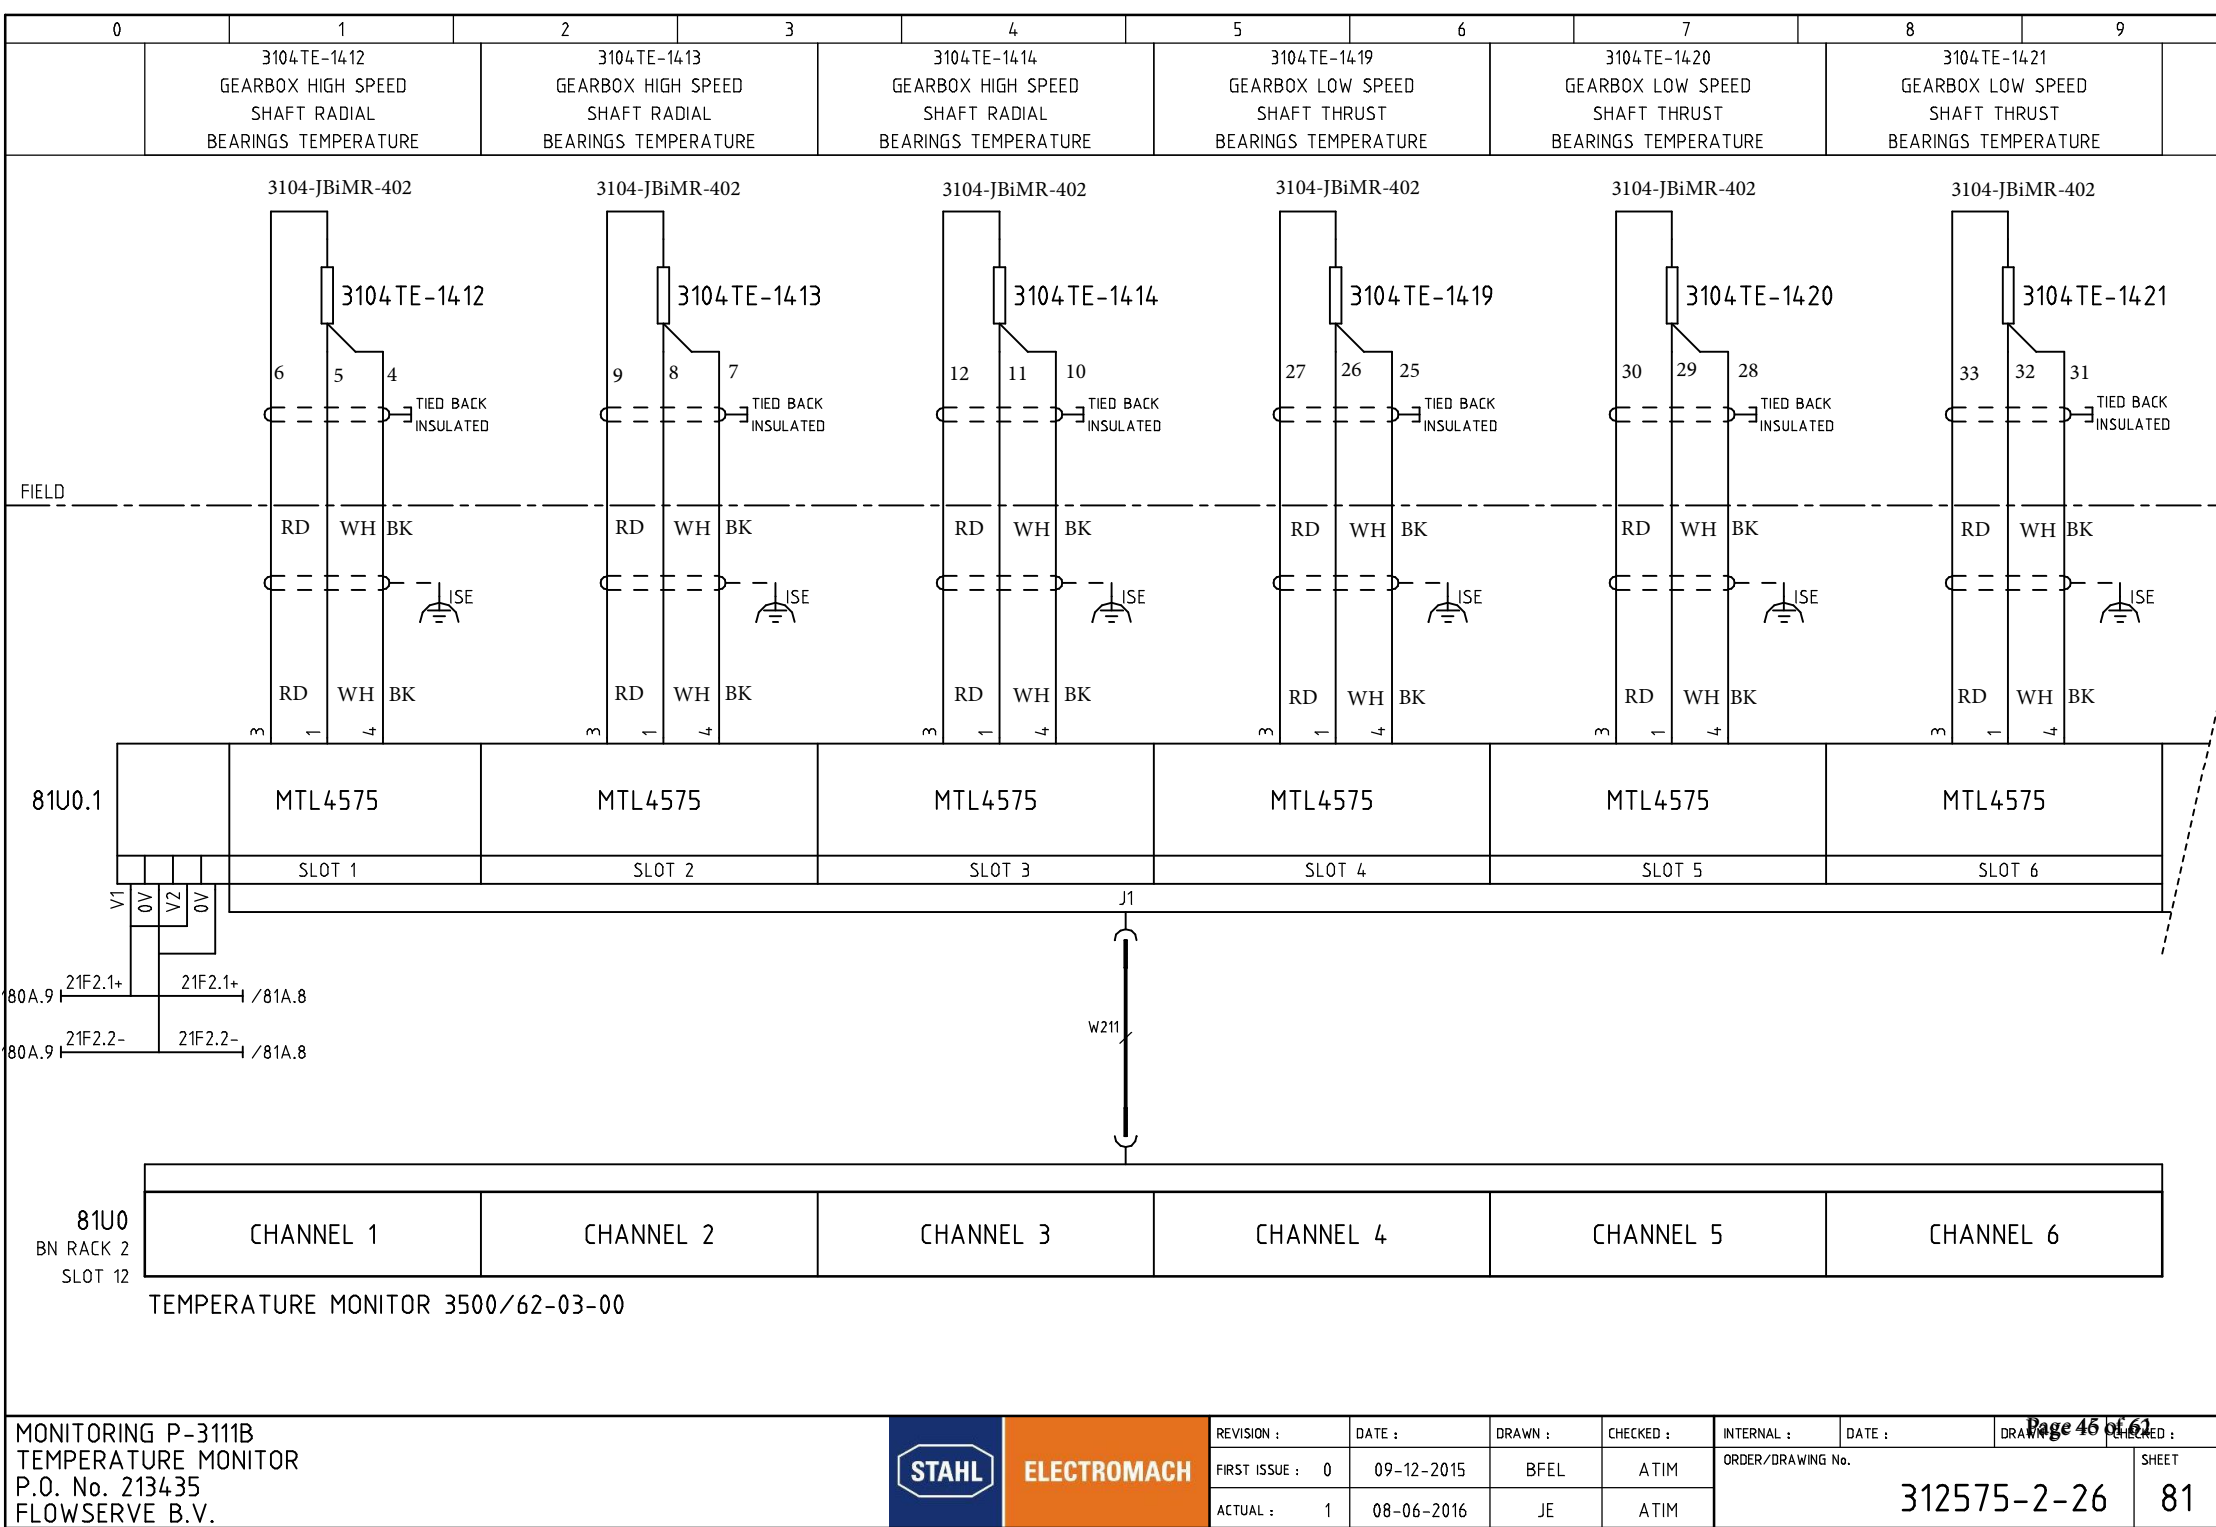


0	1	2	3	4	5	6	7	8	9

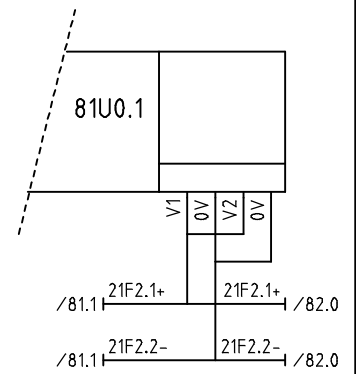

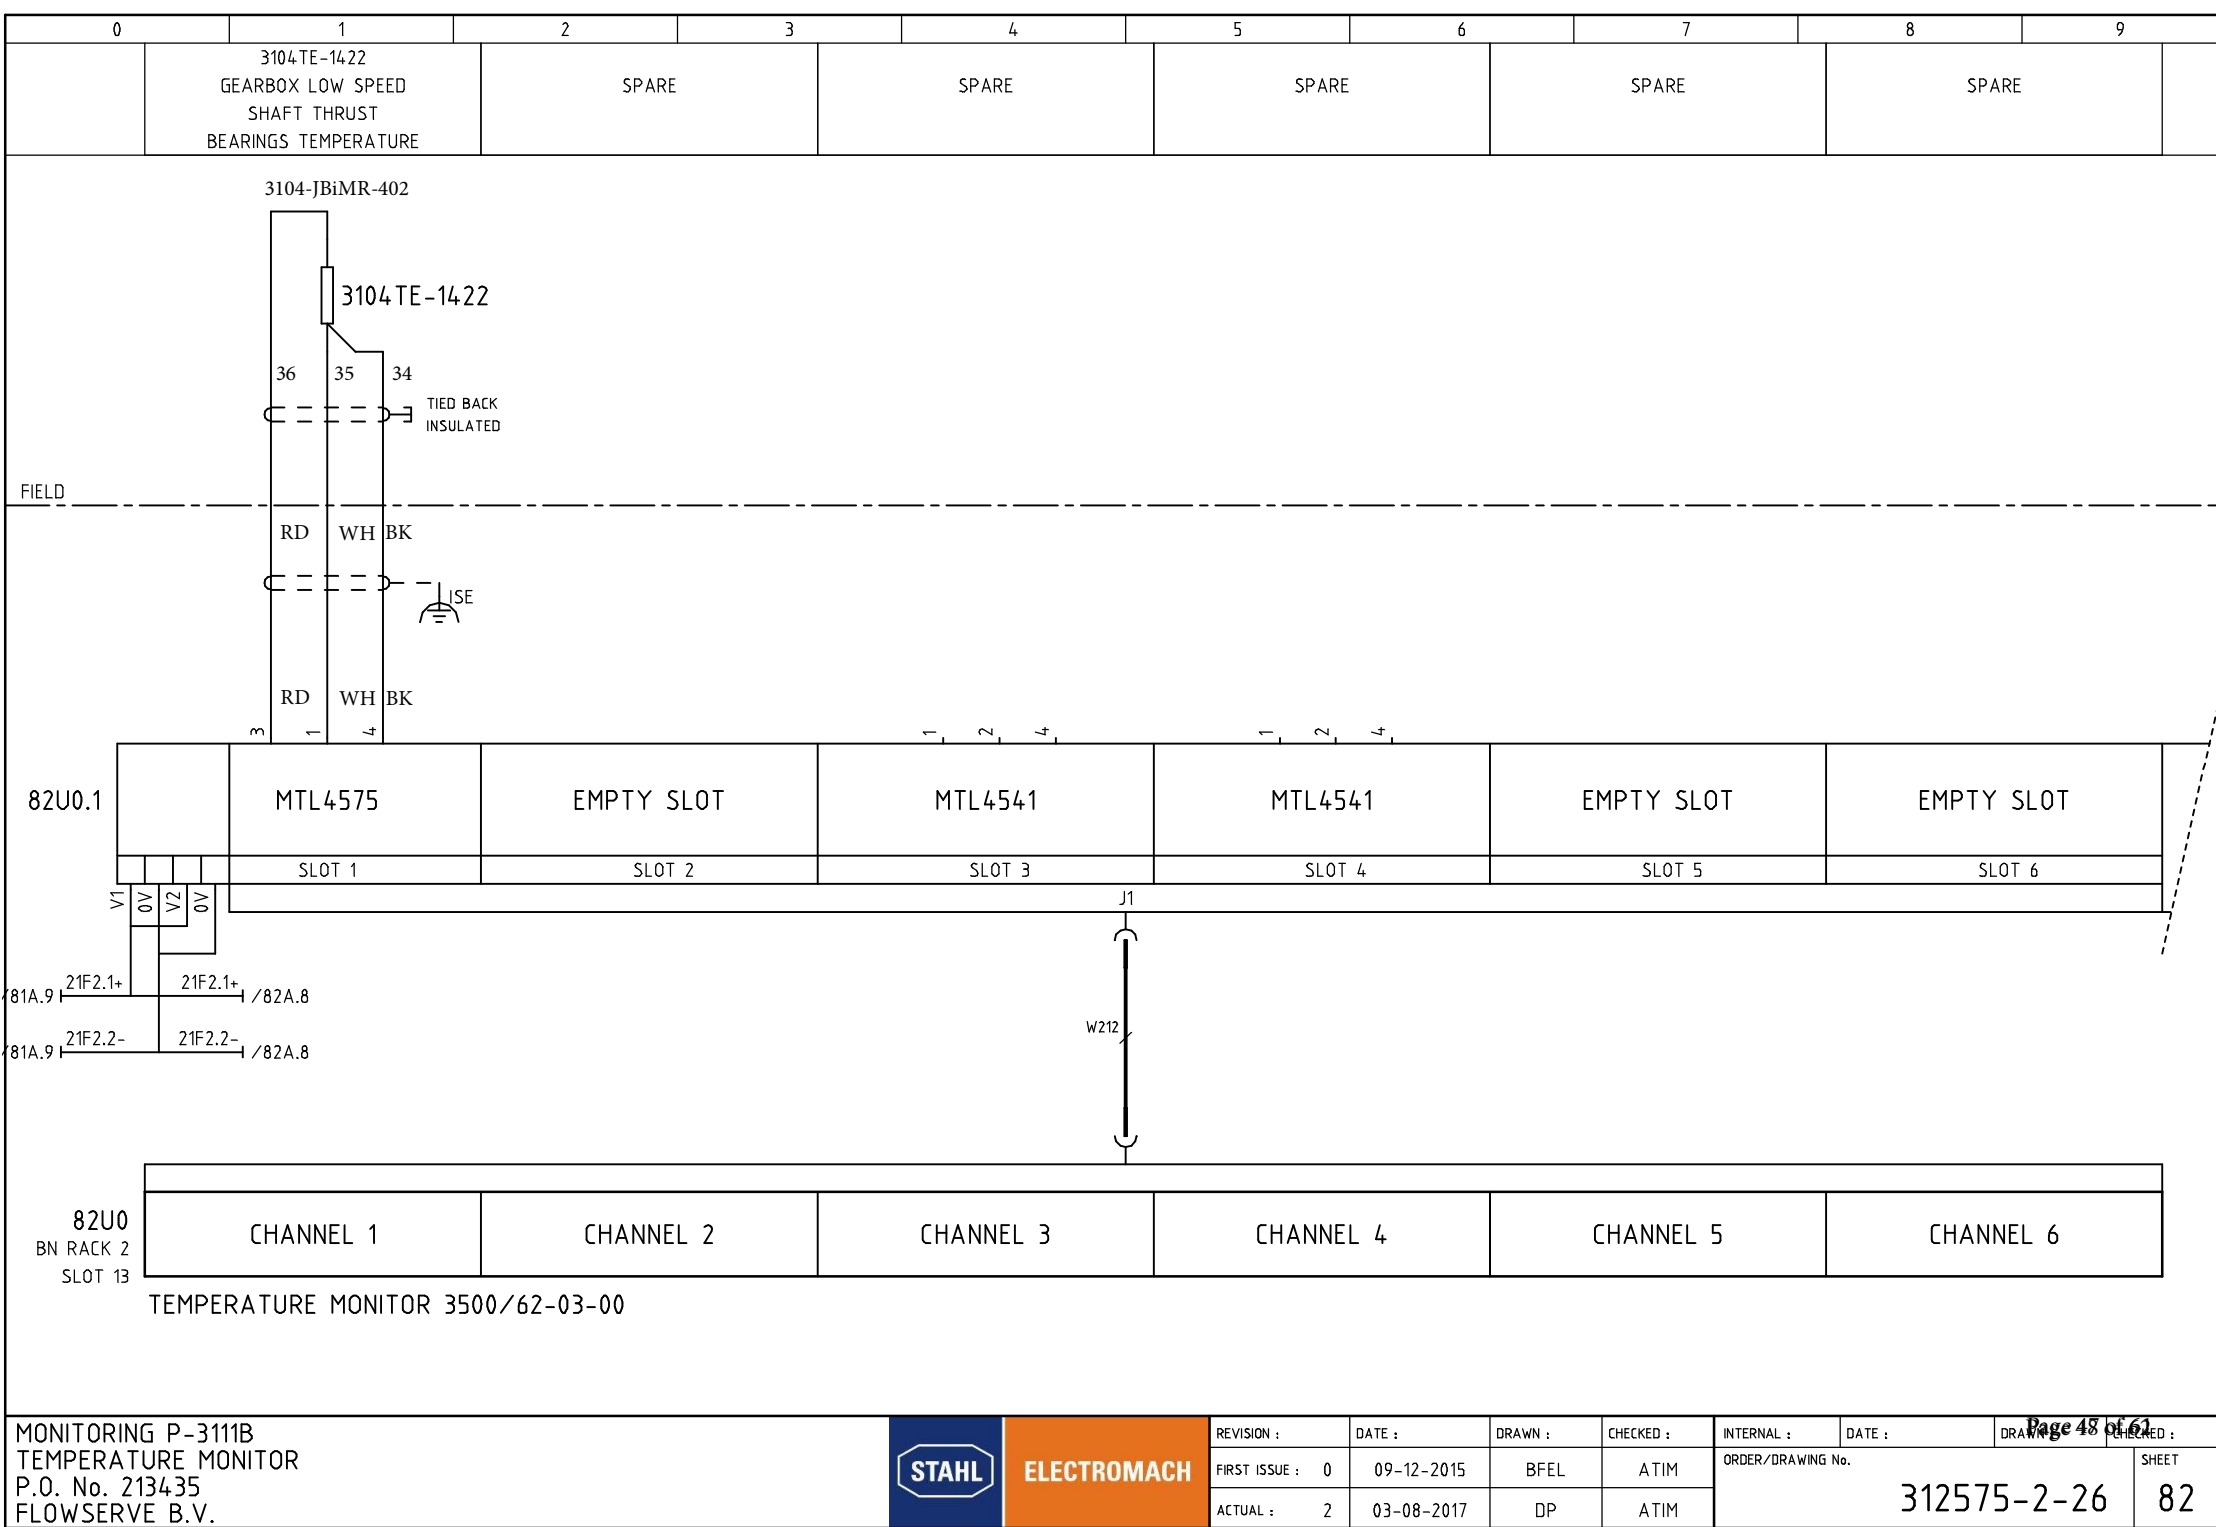



0	1	2	3	4	5	6	7	8	9

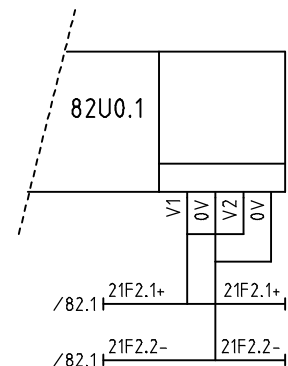


0	1	2	3	4	5	6	7	8	9
	3104XS-0429 COMMON TRIP VIBRATION 3100Z-113B		3104XS-0430 COMMON TEMPERATURE MEASUREMENT 3100Z-113B		3104XS-0428 COMMON TRIP AXIAL DISPLACEMENT 3100Z-113B		SPARE		

RELAY MODULE 3500/32-01-00


85U1
BN RACK 2
SLOT 14

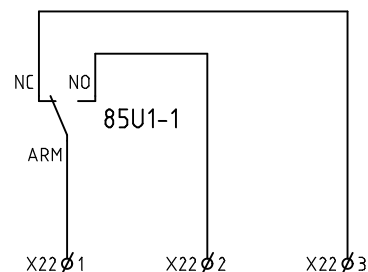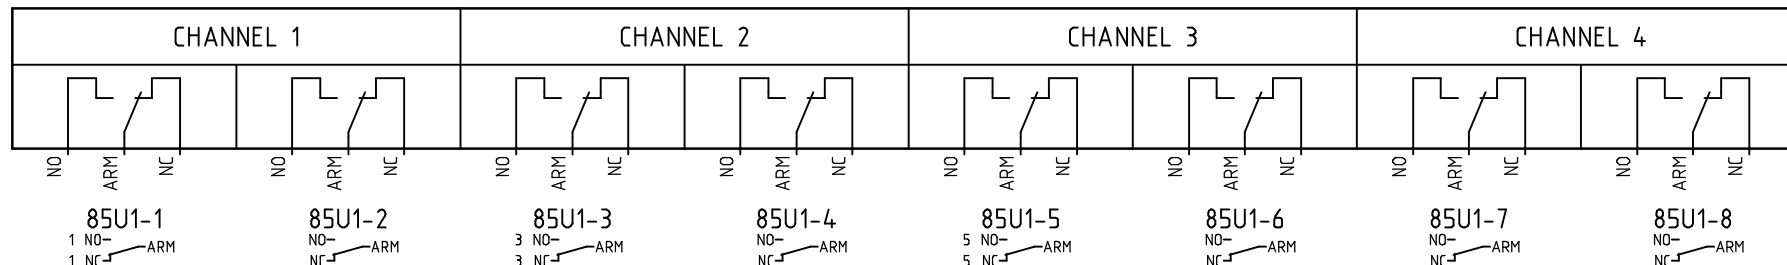

3104XS-0429

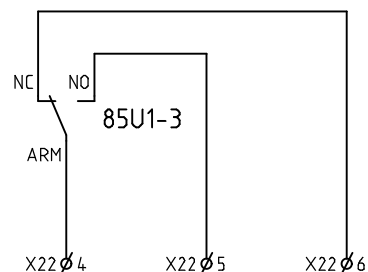

3104XS-0430

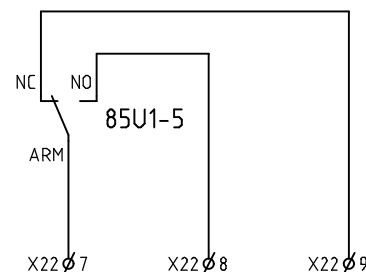

3104XS-0428

0	1	2	3	4	5	6	7	8	9
	MODBUS TCP/IP				SPARE				



COMMUNICATION GATEWAY 3500/92-04-01-00

86U1
BN RACK 1
SLOT 15

ETHERNET
10/100 BASE-T
RJ-45
IP ADDRESS :
192.168.0.10

W213
BN RACK 2
/21.3

RS485
MODBUS

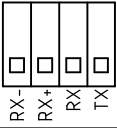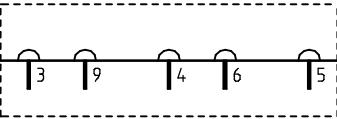

SLAVE
ADDRESS

[illegible]

TERMINAL ROW X-SPARE 1
MONITORING P-3111A
P.O. No. 213435
FLOWSERVE B.V.

ELECTROMACH

REVISION :	DATE :	DRAWN :	CHECKED :	INTERNAL :	DATE :	DRAWN :	CHECKED :
FIRST ISSUE : 0	09-12-2015	BFEL	ATIM	ORDER/DRAWING No.			
ACTUAL : 0				312575-2-26			
				SHEET 111			

